

Pike
G 75
2-2-70

MISSISSIPPI
BOARD OF WATER COMMISSIONERS
416 North State Street
Jackson, Mississippi 39201

CODED

WATER WELL DRILLERS LOG

Feb 2 1970 Fitzgerald Well Drilling Refo
date well completed firm name county well located

LANDOWNER:
Angeline Johnson
RR Magnolia Miss.
(mailing address)

| description of formations encountered | from | to |
|---------------------------------------|-----------|------------|
| <u>Red clay</u> | <u>0</u> | <u>20</u> |
| <u>Red soil</u> | <u>20</u> | <u>65</u> |
| <u>Red gravel</u> | <u>65</u> | <u>90</u> |
| <u>6' fine sand</u> | <u>90</u> | <u>94</u> |
| <u>Coarse sand</u> | <u>94</u> | <u>102</u> |

WELL LOCATION:
sec. 36 T. 2 N. R. 7 E
4 miles SSE of Magnolia
(distance) (direction) (nearest town)

WELL PURPOSE: Home
(home, irrigation, municipal, industrial)

- WELL COMPLETION DATA:
- (1) diameter (inches) 4
 - (2) total depth (feet) 102
 - (3) static water level (feet) 85 below above top of ground.
 - (4) casing Plastic 94
(material) (depth)
4 (size) if telescope see back.
 - (5) screen 8 94
(length) (depth to top)
4 (size) Plastic (material)
 - (6) pump 3/4 5
(HP) (yield gpm)
Elco (type power)
 - (7) electric log no
(yes or no)
(organization running log)
 - (8) how well bottom plugged wooden

CODED


FEB 27 1970

MISC. DIV. OF
WATER CONTROL

DRILLERS REMARKS:

If well telescopes please sketch and show depths.

GROUND LEVEL

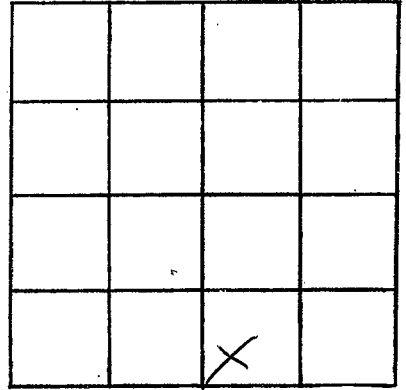

SECTION 36

Please indicate well location X.

ADDITIONAL INFORMATION

If more than one screen,
show locations of each on sketch.