

Pike  
G 76  
2-4-70

MISSISSIPPI  
BOARD OF WATER COMMISSIONERS  
416 North State Street  
Jackson, Mississippi 39201

**CODED**

WATER WELL DRILLERS LOG

2-4 1970 Lyons Well Co Pike  
date well completed firm name county well located

LANDOWNER:  
Bobby Kennedy  
R.R. Magnolia Miss.  
(mailing address)

description of formations encountered	from	to
<u>Red clay</u>	<u>0</u>	<u>15</u>
<u>Coarse sand &amp; gravel</u>	<u>15</u>	<u>25</u>
<u>Blue clay</u>	<u>25</u>	<u>130</u>
<u>Coarse sand</u>	<u>130</u>	<u>143</u>

WELL LOCATION:  
sec. 15 T 2 (N) R 7 (E)  
2 miles W of Magnolia  
(distance) (direction) (nearest town)

WELL PURPOSE: Home  
(home, irrigation, municipal, industrial)

**CODED**


- WELL COMPLETION DATA:
- (1) diameter (inches) 4
  - (2) total depth (feet) 143
  - (3) static water level (feet) 3 below top of ground
  - (4) casing Plastic 135  
(material) (depth)  
4 if telescope see back.  
(size)
  - (5) screen 8 135  
(length) (depth to top)  
4 Plastic  
(size) (material)
  - (6) pump 1/2 12  
(HP) (yield gpm)  
Electric  
(type power)
  - (7) electric log Yes  
(yes or no)  
(organization running log)
  - (8) how well bottom plugged well plug

DRILLERS REMARKS:

FEB 27 1970  
MISS. DIV. OF  
WATER COMMS.

If well telescopes please sketch and show depths.

GROUND LEVEL

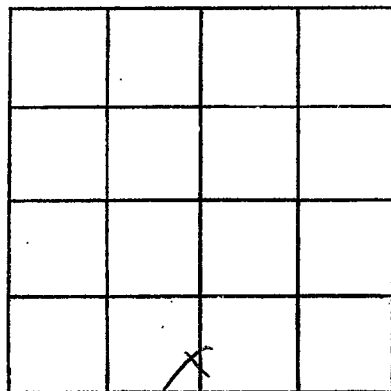

SECTION 15

Please indicate well location X.

ADDITIONAL INFORMATION

If more than one screen,  
show locations of each on sketch.