

PIKE

G 77

1-28-71

MISSISSIPPI BOARD OF WATER COMMISSIONERS
416 North State Street
Jackson, Mississippi 39201

FEB 19 1971

MISS. BD. OF WATER COMMISSIONERS

WATER WELL DRILLERS LOG

CODED

Jan 28, 1971
date well completed

Chester Keener
firm name

Pike
county well located

LANDOWNER:

Leslie Rogers

description of formations encountered

from to

422 Magnolia
(mailing address)

clay 0 10

sand 10 30

chalk & sand 30 65

chalk 65 85

sand 85 95

chalk 95 110

sand & gravel 110 120

WELL LOCATION:

sec 30 T 7 N R 7 E
S W

(distance) miles of (direction) (nearest town)

WELL PURPOSE:

Home (home, irrigation, municipal, industrial)

WELL COMPLETION DATA:

- (1) diameter (inches) 4"
- (2) total depth (feet) 120
- (3) static water level (feet) 90 below top of ground.
- (4) casing West Bottom (material) (depth)

(size) if telescope see back.

- (5) screen 6' (length) 114 (depth to top) 4" (size) Plaster (material)

- (6) pump 1/2 sub 12 (HP) (yield gpm) Elect. (type power)

- (7) electric log No (yes or no)

(organization running log)

- (8) how well bottom plugged wooden plug


DRILLERS REMARKS:

New house

CODED

If well telescopes please sketch and show depths.

GROUND LEVEL

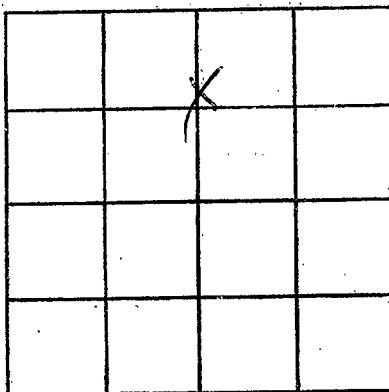

SECTION 30

Please indicate well location X.

ADDITIONAL INFORMATION

If more than one screen, show locations of each on sketch.