

~~PIKE~~
~~PIKE~~
 G 78
 1-25-71

MISSISSIPPI
 BOARD OF WATER COMMISSIONERS
 416 North State Street
 Jackson, Mississippi 39201

CODED

WATER WELL DRILLERS LOG

PIKE

25 Jan 1971 S.P. Waterwell ~~PIKE~~
 date well completed firm name county well located

LANDOWNER:
 Monroe Dillon
 Magnolia
 (mailing address)

description of formations encountered	from	to
slat	0	25
Redbed	25	40
clash	40	65
good cherty	65	75
good blk	75	90
good	90	125

WELL LOCATION:
 sec. 18 T. 2 R. 7 E
 S W
 5 miles west of Magnolia
 (distance) (direction) (nearest town)

WELL PURPOSE:
 (home, irrigation, municipal, industrial)

WELL COMPLETION DATA:

(1) diameter (inches) 4

(2) total depth (feet) 125

(3) static water level (feet) 90 below above top of ground.

(4) casing (material) PL (depth) 119
 (size) if telescope see back.

(5) screen (length) 6 (depth to top) 119
 (size) PL (material)

(6) pump 1/2 (HP) 10 (yield gpm)
 elect (type power)

(7) electric log (yes or no)

(organization running log)

(8) how well bottom plugged wood

CODED


FEB 26 1971

MISSISSIPPI
 BOARD OF WATER COMMISSIONERS
 JACKSON, MISSISSIPPI

DRILLERS REMARKS:

If well telescopes please sketch and show depths.

GROUND LEVEL

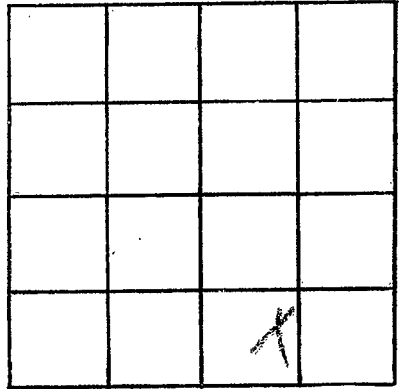

SECTION B

Please indicate well location X.

ADDITIONAL INFORMATION

A series of horizontal lines for writing additional information.

If more than one screen, show locations of each on sketch.