

PIKE
G 79
Z-18-71

MISSISSIPPI
BOARD OF WATER COMMISSIONERS
416 North State Street
Jackson, Mississippi 39201

MAR 26 1971

MISS. BD. OF
WATER COMM.

WATER WELL DRILLERS LOG

CODED

18 Feb 1971 date well completed
988 Water Well firm name
Pike county well located

LANDOWNER:
Ruben Kirkland
Magnolia
(mailing address)

description of formations encountered	from	to
Clay	0	20
Red Sand clay	20	45
Chalky Sand	45	75
Sand	75	85
Clay	85	100
Sand	100	138

WELL LOCATION:
sec. 18 T. 2 N R. 7 E
5 miles West of Magnolia
(distance) (direction) (nearest town)

WELL PURPOSE:
(home, irrigation, municipal, industrial)


- WELL COMPLETION DATA:
- (1) diameter (inches) 4
 - (2) total depth (feet) 138
 - (3) static water level (feet) 90 below above top of ground.
 - (4) casing pl 132
(material) (depth)
(size) if telescope see back.
 - (5) screen 6' 132
(length) (depth to top)
41 pl
(size) (material)
 - (6) pump 1/2 8
(HP) (yield gpm)
Elect
(type power)
 - (7) electric log (yes or no)
 - (organization running log)
 - (8) how well bottom plugged covered

CODED

DRILLERS REMARKS:

If well telescopes please sketch and show depths.

GROUND LEVEL

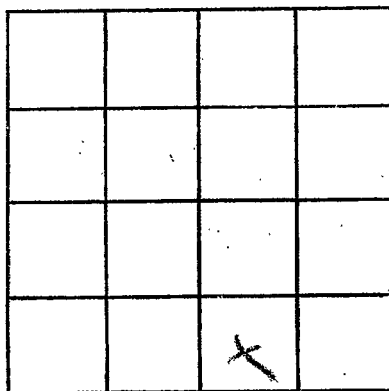

SECTION 12

Please indicate well location X.

ADDITIONAL INFORMATION

If more than one screen, show locations of each on sketch.