

PIKE
G80
3-4-71

MISSISSIPPI
BOARD OF WATER COMMISSIONERS
416 North State Street
Jackson, Mississippi 39201

CODED

WATER WELL DRILLERS LOG

5-4 1971 Fitzgerald Pike
date well completed firm name county well located

LANDOWNER:
Curtis Landry
B.R. McComb, Miss.
(mailing address)

description of formations encountered	from	to
<u>Red clay</u>	<u>0</u>	<u>20</u>
<u>Red sand</u>	<u>20</u>	<u>80</u>
<u>Coarse sand & gravel</u>	<u>80</u>	<u>117</u>

WELL LOCATION:
sec. 4 T. 2 N. R. 7 E
6 miles SW of McComb
(distance) (direction) (nearest town)

WELL PURPOSE:
Home
(home, irrigation, municipal, industrial)

- WELL COMPLETION DATA:
- (1) diameter (inches) 4" #4
 - (2) total depth (feet) 117
 - (3) static water level (feet): 80 below above top of ground.
 - (4) casing Plastic, 109,
(material) (depth),
4 if telescope see back.
(size)
 - (5) screen 8, 109
(length) (depth to top),
4, Plastic
(size) (material)
 - (6) pump 1, 6
(HP) (yield gpm),
Electric
(type power)
 - (7) electric log Yes (yes or no)
(organization running log)
 - (8) how well bottom plugged solidly

CODED


MAR 31 1971

DRILLERS REMARKS:

MISC. DD. OF
WATER COMM.

If well telescopes please sketch and show depths.

GROUND LEVEL

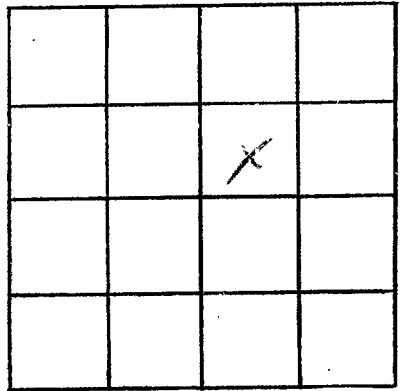

SECTION 4

Please indicate well location X.

ADDITIONAL INFORMATION

If more than one screen, show locations of each on sketch.