

PIKE
G81
4-30-71

MISSISSIPPI
BOARD OF WATER COMMISSIONERS
416 North State Street
Jackson, Mississippi 39201

CODED

WATER WELL DRILLERS LOG

30 April 1971 *S. P. Water Well* *Pike*
date well completed firm name county well located

LANDOWNER:
B. B. Albritton

May.
(mailing address)

WELL LOCATION:
sec *24* T *2* N R *7* E
2 miles *South* of *May.*
(distance) (direction) (nearest town)

description of formations encountered	from	to
<i>Clay</i>	<i>0</i>	<i>25</i>
<i>Chalk</i>	<i>25</i>	<i>45</i>
<i>S. S. Chalk</i>	<i>45</i>	<i>65</i>
<i>Soil Prof</i>	<i>65</i>	<i>85</i>
<i>Chalk</i>	<i>85</i>	<i>95</i>
<i>Sand</i>	<i>95</i>	<i>120</i>

WELL PURPOSE:
(home, irrigation, municipal, industrial)

WELL COMPLETION DATA:

(1) diameter (inches) *4*

(2) total depth (feet) *120*

(3) static water level (feet) *80* below top of ground.

(4) casing *PI* *114*
(material) (depth)
(size) if telescope see back.

(5) screen *6* *114*
(length) (depth to top)
4 *PI*
(size) (material)

(6) pump *1/2* *10*
(HP) (yield gpm)
Electric
(type power)

(7) electric log (yes or no)

(organization running log)

(8) how well bottom plugged *covered*

CODED


MAY 31 1971

MISS. DD. OF WATER

DRILLERS REMARKS:

If well telescopes please sketch and show depths.

GROUND LEVEL

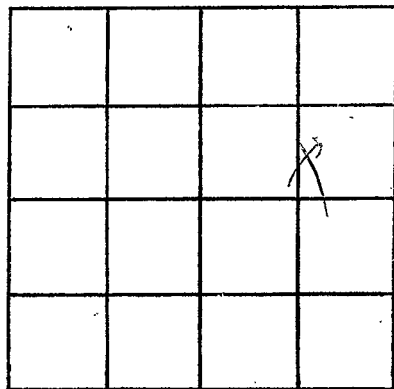

SECTION 24

Please indicate well location X.

ADDITIONAL INFORMATION

If more than one screen,
show locations of each on sketch.