

PIKE
G 82
6-9-71

MISSISSIPPI
BOARD OF WATER COMMISSIONERS
416 North State Street
Jackson, Mississippi 39201

CODED

WATER WELL DRILLERS LOG

9 June 1971 549 Water Well R. K. e.
date well completed firm name county well located

LANDOWNER:
Bornil Coleman

Magnolia
(mailing address)

WELL LOCATION:
sec. 15 T 2 N R 7 E
S W

2 miles West of Mag.
(distance) (direction) (nearest town)

description of formations encountered	from	to
Clay	0	30
Chalk	30	50
gulf chalk	50	75
Chalk	75	95
Sand	95	130

WELL PURPOSE:
(home, irrigation, municipal, industrial)

- WELL COMPLETION DATA:
- (1) diameter (inches) 4
 - (2) total depth (feet) 130
 - (3) static water level (feet) 30 below top of ground.
 - (4) casing 41 124
(material) (depth)
(size) if telescope see back.
 - (5) screen 6 124
(length) (depth to top)
4 41
(size) (material)
 - (6) pump 1/2 8
(HP) (yield gpm)
Elect.
(type power)
 - (7) electric log no
(yes or no)

CODED

(organization running log)

(8) how well bottom plugged wood


JUN 14 1971

MISS. BD. OF
WATER COMM.

DRILLERS REMARKS:

If well telescopes please sketch and show depths.

GROUND LEVEL

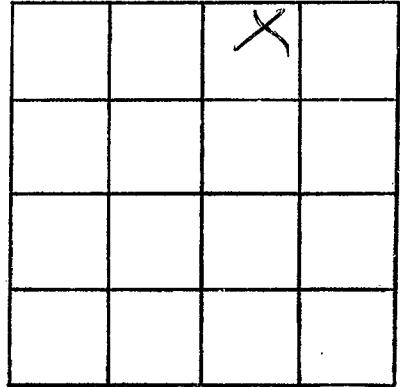

SECTION 15

Please indicate well location X.

ADDITIONAL INFORMATION

If more than one screen,
show locations of each on sketch.