

Pike  
 G-84  
 7-8-71

MISSISSIPPI  
 BOARD OF WATER COMMISSIONERS  
 416 North State Street  
 Jackson, Mississippi 39201

**CODED**

WATER WELL DRILLERS LOG

7-8 1971 *Fitzgerald Well Drilling* *Pike*  
 date well completed firm name county well located


| LANDOWNER:   | description of formations encountered                                 | from                               | to                                   |
|--|---|------------------------------------|--------------------------------------|
| <i>Mavis Honea</i>   |   |                                    |                                      |
| <i>R.R. Magnolia, Mrs</i><br>(mailing address)   | <i>Red Clay</i><br><i>Red Sand</i><br><i>Coarse sand &amp; gravel</i> | <i>0</i><br><i>20</i><br><i>80</i> | <i>20</i><br><i>80</i><br><i>106</i> |
| WELL LOCATION:<br>sec. <i>27</i> <i>2</i> N R <i>7</i> E<br>S. W<br><i>3</i> miles <i>SW</i> of <i>Magnolia</i><br>(distance) (direction) (nearest town) |   |                                    |                                      |
| WELL PURPOSE:<br>(home, irrigation, municipal, industrial) <i>Home</i>   |   |                                    |                                      |
| WELL COMPLETION DATA:  | <b>CODED</b>  |                                    |                                      |
| (1) diameter (inches) <i>4</i>   |   |                                    |                                      |
| (2) total depth (feet) <i>106</i>  |   |                                    |                                      |
| (3) static water level (feet) <i>65</i> below above top of ground.   |   |                                    |                                      |
| (4) casing: <i>plastic</i> <i>98</i><br>(material) (depth)   |   |                                    |                                      |
| <i>4</i><br>(size) if telescope see back.  |   |                                    |                                      |
| (5) screen <i>8</i> <i>98</i><br>(length) (depth to top)   |   |                                    |                                      |
| <i>4</i><br>(size) <i>plastic</i><br>(material)  |   |                                    |                                      |
| (6) pump <i>1/2</i> <i>10</i><br>(HP) (yield gpm)  |   |                                    |                                      |
| <i>electric</i><br>(type power)  |   |                                    |                                      |
| (7) electric log <i>no</i><br>(yes or no)  |   |                                    |                                      |
| (organization running log)   |   |                                    |                                      |
| (8) how well bottom plugged <i>woolly</i>  |   |                                    |                                      |
| DRILLERS REMARKS:  |   |                                    |                                      |

AUG 11 1971

MISS. BD. OF  
 WATER COMMISSIONERS

If well telescopes please sketch and show depths.

GROUND LEVEL

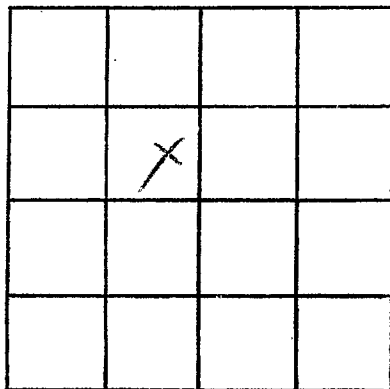

SECTION 27

Please indicate well location X.

ADDITIONAL INFORMATION

If more than one screen,  
show locations of each on sketch.