

Pike
G85
9-9-71

MISSISSIPPI
BOARD OF WATER COMMISSIONERS
416 North State Street
Jackson, Mississippi 39201

WATER WELL DRILLERS LOG

CODED

9-9-71 date, well completed 21 February 1971 firm name 390 county well located

| LANDOWNER: | description of formations encountered | from | to |
|--|---------------------------------------|------|-----|
| James Rimes | Red Clay | 0 | 28 |
| R.R. Magnolia Miss. (mailing address) | Red Soil | 28 | 100 |
| | Crane Soil & gravel | 100 | 117 |

WELL LOCATION:
sec. 27 T. 2 N. S. R. 7 E
2 miles SW of Magnolia
(distance) (direction) (nearest town)

WELL PURPOSE: Domestic
(home, irrigation, municipal, industrial)

- WELL COMPLETION DATA:
- (1) diameter (inches) 4
 - (2) total depth (feet) 117
 - (3) static water level (feet) 52 below top of ground.
 - (4) casing Plastic (material), 109 (depth).
4 (size) If telescope see back.
 - (5) screen 8 (length), 109 (depth to top).
4 (size), Plastic (material)
 - (6) pump 1 (HP), 6 (yield-gpm).
6 hp (type-power)
 - (7) electric log no (yes-or-no)
(organization-running-log)

CODED


UGT 28 1971

MISS. BD. OF
WATER COM.

DRILLERS REMARKS:

If well telescopes please sketch and show depths.

GROUND LEVEL

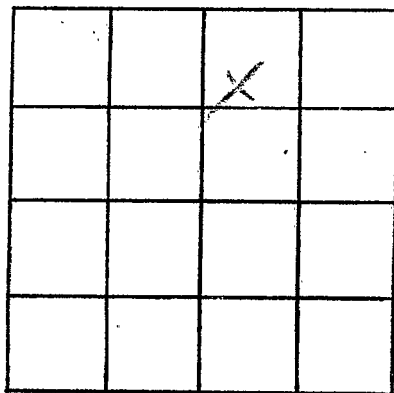

SECTION 27

Please indicate well location X.

ADDITIONAL INFORMATION

If more than one screen,
show locations of each on sketch.