

Pike
G86
10-11-71

MISSISSIPPI
BOARD OF WATER COMMISSIONERS
416 North State Street
Jackson, Mississippi 39201

WATER WELL DRILLERS LOG

CODED

10-11 date well completed 1971 firm name *Fitzgerald Well Serv* *Pike* county well located

LANDOWNER:	description of formations encountered	from	to
<i>Oliver Goodly Jr.</i>			
<i>R.R. McComb</i> (mailing address)	<i>Red sand</i>	<i>20</i>	<i>110</i>
	<i>Coarse sand & gravel</i>	<i>110</i>	<i>119</i>

WELL LOCATION:
sec. 4 T 2 N R 7 E
S W
6 miles SW of McComb
(distance) (direction) of (nearest town)

WELL PURPOSE: Home
(home, irrigation, municipal, industrial)

- WELL COMPLETION DATA:
- (1) diameter (inches) 4
 - (2) total depth (feet) 119
 - (3) static water level (feet) 90 below above top of ground.
 - (4) casing Plastic, 1 1/2 (material) (depth)
4 (size) if telescope see back.
 - (5) screen 8, 111 (length) (depth to top)
4 (size), Plastic (material)
 - (6) pump 1 (HP) 6 (yield gpm)
Electric (type power)
 - (7) electric log no (yes or no)
(organization running log)
 - (8) how well bottom plugged goodly

CODED


OCT 28 1971

DRILLERS REMARKS:

MISS. ED. CH
WATER COMM.

If well telescopes please sketch and show depths.

GROUND LEVEL

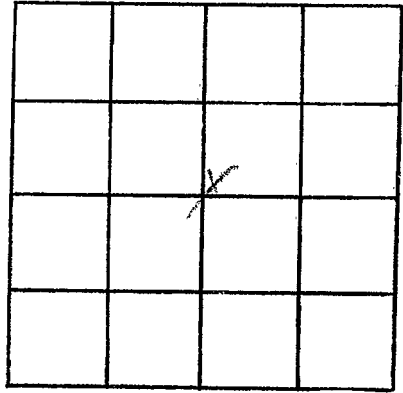

SECTION 4

Please indicate well location X.

ADDITIONAL INFORMATION

If more than one screen, show locations of each on sketch.