

Pike  
G 87  
9-2-71

MISSISSIPPI  
BOARD OF WATER COMMISSIONERS  
416 North State Street  
Jackson, Mississippi 39201  
WATER WELL DRILLERS LOG

**CODED**

2 Sept 1971 date well completed  
S & P Water Well firm name  
Pike county well located

LANDOWNER:  
Wagner Noel  
Magnolia  
(mailing address)

description of formations encountered	from	to
Clay	0	20
Clay shale	20	35
Sand	35	60
shale	60	75
red	75	118

WELL LOCATION:  
sec. 20 T 2 N R 7 E  
5 miles west of Magnolia  
(distance) (direction) (nearest town)

WELL PURPOSE:  
(home, irrigation, municipal, industrial)

- WELL COMPLETION DATA:
- (1) diameter (inches) 4
  - (2) total depth (feet) 118
  - (3) static water level (feet) 70 below top of ground.
  - (4) casing (material) 112 (depth)
  - (size) if telescope see back.
  - (5) screen 6 (length) 112 (depth to top)
  - (size) (material)
  - (6) pump 1/2 (HP) 80 (yield gpm)
  - (type power) electric
  - (7) electric log (yes or no)

**CODED**

(organization running log)  
(8) how well bottom plugged Wood


NOV 10 1971

DRILLERS REMARKS:

MISS. BD. OF  
WATER COMM.

If well telescopes please sketch and show depths.

GROUND LEVEL

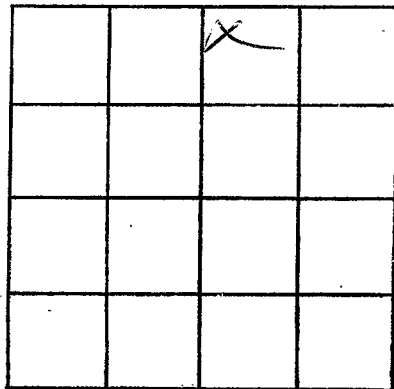

SECTION 20

Please indicate well location X.

ADDITIONAL INFORMATION

If more than one screen,  
show locations of each on sketch.