

Pike
G88
9-8-71

MISSISSIPPI
BOARD OF WATER COMMISSIONERS
416 North State Street
Jackson, Mississippi 39201

CODED

WATER WELL DRILLERS LOG

8 Sept 1971 J.T. Co. water & gas Pike
date well completed firm name county well located

LANDOWNER:
Joel Lang
Magnolia
(mailing address)

WELL LOCATION:
sec. 3 T 2 N R 7 E
1 miles S-E of Map
(distance) (direction) (nearest town)

WELL PURPOSE:
(home, irrigation, municipal, industrial)

- WELL COMPLETION DATA:
- (1) diameter (inches) 4
 - (2) total depth (feet) 122
 - (3) static water level (feet) 40 below top of ground
 - (4) casing (material) PL (depth) 116
(size) If telescope see back.
 - (5) screen (length) 6 (depth to top) 116
(size) 4 (material) PL
 - (6) pump 1/2 (HP) 8 (yield gpm)
electric (type power)
 - (7) electric log (yes or no)
 - (organization running log)
 - (8) how well bottom plugged wood

description of formations encountered	from	to
Clay	0	15
Clay sand	15	25
Sand	25	60
Chalk	60	75
Sand	75	122

CODED


NOV 10 1971

DRILLERS REMARKS:

MISS. BD. OF
WATER COM.

If well telescopes please sketch and show depths.

GROUND LEVEL

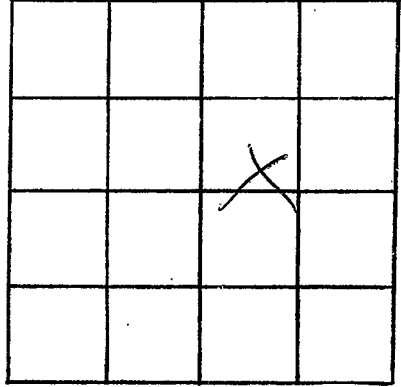

SECTION 3

Please indicate well location X.

ADDITIONAL INFORMATION

If more than one screen,
show locations of each on sketch.