

MISSISSIPPI  
BOARD OF WATER COMMISSIONERS  
416 North State Street  
Jackson, Mississippi 39201

**CODED**

WATER WELL DRILLERS LOG

Pike  
G92  
1-18-72

Jan 18 1972 Chester Keene Pike  
date well completed firm name county well located

LANDOWNER: Alabama Coal  
Rt-3, Magnolia

(mailing address)

WELL LOCATION:

sec. 33 T 2 N R 7 E  
5 miles SW Magnolia  
(distance) (direction) (nearest town)

WELL PURPOSE: Home  
(home, irrigation, municipal, industrial)

WELL COMPLETION DATA:

- (1) diameter (inches) 4"
- (2) total depth (feet) 127
- (3) static water level (feet) 110 below top of ground. above
- (4) casing Plast Bellum  
(material) (depth)
- (size) if telescope see back.
- (5) screen 6' 14'  
(length) (depth to top)
- 4" Plast  
(size) (material)
- (6) pump 5 sub 10  
(HP) (yield gpm)
- Elect  
(type power)
- (7) electric log NO  
(yes or no)

(organization running log)

(8) how well bottom plugged  
wooden plug

DRILLERS REMARKS:

new haul.

description of formations encountered


from to

<u>Red clay</u>	<u>0</u>	<u>17</u>
<u>Red sand</u>	<u>17</u>	<u>92</u>
<u>Sand &amp; gravel</u>	<u>92</u>	<u>108</u>
<u>Mixed sand &amp; shells &amp; gravel</u>	<u>108</u>	<u>120</u>
<u>Coarse sand</u>	<u>120</u>	<u>127</u>

**CODED**

If well telescopes please sketch and show depths.

GROUND LEVEL

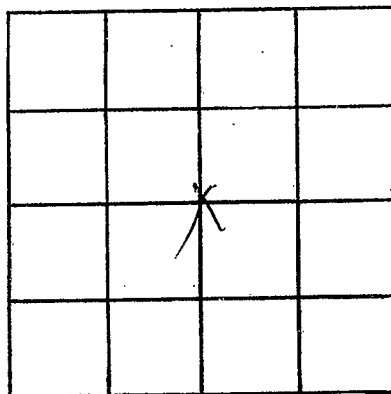

SECTION 33

Please indicate well location X.

ADDITIONAL INFORMATION

If more than one screen, show locations of each on sketch.