

Pike  
G 95  
6-22-72

MISSISSIPPI  
BOARD OF WATER COMMISSIONERS  
416 North State Street  
Jackson, Mississippi 39201

**CODED**

WATER WELL DRILLERS LOG

June 22 1972 Chester Reeves Pike  
date well completed firm name county well located

LANDOWNER: Lucille Cook  
Rt 4, Magnolia  
(mailing address)

description of formations encountered	from	to
<u>sand &amp; gravel</u>	<u>0</u>	<u>54</u>
<u>pink chalk</u>	<u>54</u>	<u>62</u>
<u>gravel &amp; sand</u>	<u>62</u>	<u>70</u>

WELL LOCATION:

sec 35 T 2 N R 7 E  
4 miles S of Magnolia  
(distance) (direction) (nearest town)

WELL PURPOSE: Home  
(home, irrigation, municipal, industrial)

WELL COMPLETION DATA:

- (1) diameter (inches) 4 1/2
- (2) total depth (feet) 70
- (3) static water level (feet) 144 below top of ground
- (4) casing plastic (material) bottom (depth)  
If telescope see back.
- (5) screen 6' (length) 6 1/2' (depth to top)  
4" (size) plastic (material)
- (6) pump 1/2 HP (type power) 15 (yield gpm)
- (7) electric log No (yes or no)

(organization running log)

(8) how well bottom plugged wooden plug

**CODED**


JUL 20 1972

MISS. BU. OF WATER COMMISSIONERS

DRILLERS REMARKS:

If well telescopes please sketch and show depths.

GROUND LEVEL

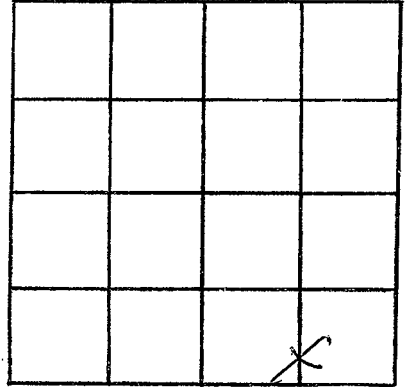

SECTION 3.5

Please indicate well location X.

ADDITIONAL INFORMATION

If more than one screen, show locations of each on sketch.