

Pike
G96
7-13-72

MISSISSIPPI
BOARD OF WATER COMMISSIONERS
416 North State Street
Jackson, Mississippi 39201

WATER WELL DRILLERS LOG

CODED

7-13
date well completed

1972 Fitzgerald Well Serv
firm name

Pike
county well located

LANDOWNER:	description of formations encountered	from	to
New Star Church			
R.R. Magnolia (mailing address)	Red Clay	0	20
	Red Sand	20	70
WELL LOCATION:	Red gravel	70	120
sec. 33 T 2 N R 7 E 4 miles SW of Magnolia (distance) (direction) (nearest town)	Coarse sand & gravel	120	133
WELL PURPOSE: (home, irrigation, municipal, industrial)			
WELL COMPLETION DATA:			
(1) diameter (inches) 4			
(2) total depth (feet) 133			
(3) static water level (feet) 100 below top of ground			
(4) casing (material) Plastic (depth) 125			
4 (size) if telescope see back.			
(5) screen (length) 8 (depth to top) 125			
4 (size) Plastic (material)			
(6) pump (HP) 1/2 (yield gpm) 10			
electric (type power) elec			
(7) electric log (yes or no) no			
(organization running log)			
(8) how well bottom plugged good			
DRILLERS REMARKS:			


CODED

AUG 7 1972

MISS. DD. OF
WATER CONTROL

If well telescopes please sketch and show depths.

GROUND LEVEL

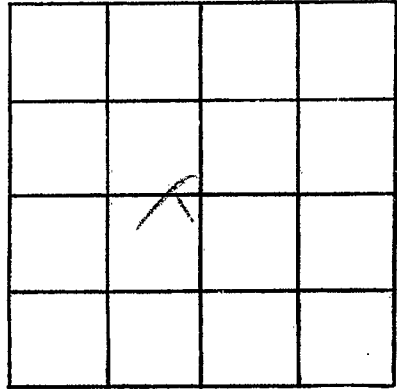

SECTION 33

Please indicate well location X.

ADDITIONAL INFORMATION

If more than one screen,
show locations of each on sketch.