

Pike  
G97  
7-13-72

MISSISSIPPI  
BOARD OF WATER COMMISSIONERS  
416 North State Street  
Jackson, Mississippi 39201

**CODED**

WATER WELL DRILLERS LOG

Pike

13.5 Jul  
date well completed

1972 S & P Water Well  
firm name

county well located

LANDOWNER:	description of formations encountered	from	to
D.H. Beacham Magnolia Miss (mailing address)			
WELL LOCATION:			
sec. <u>23</u> T. <u>2</u> S. R. <u>7</u> E. 2 miles S of Magnolia (distance) (direction) (nearest town)			
WELL PURPOSE: (home, irrigation, municipal, industrial)			
WELL COMPLETION DATA:			
(1) diameter (inches) <u>4</u>			
(2) total depth (feet) <u>212</u>			
(3) static water level (feet) <u>30</u> below top of ground.			
(4) casing <u>PI</u> <u>200</u> (material) (depth)			
<u>        </u> If telescope see back. (size)			
(5) screen <u>12</u> <u>200</u> (length) (depth to top)			
<u>4</u> <u>PI</u> (size) (material)			
(6) pump <u>None</u> <u>75</u> (HP) (yield gpm)			
<u>None</u> (type power)			
(7) electric log <u>        </u> (yes or no)			
<u>        </u> (organization running log)			
(8) how well bottom plugged <u>wool</u>			
DRILLERS REMARKS: Well Flow About 25 GPM.			


**CODED**

SEP 1 1972

MISS. DE. OF  
WATER BOARD

If well telescopes please sketch and show depths.

GROUND LEVEL

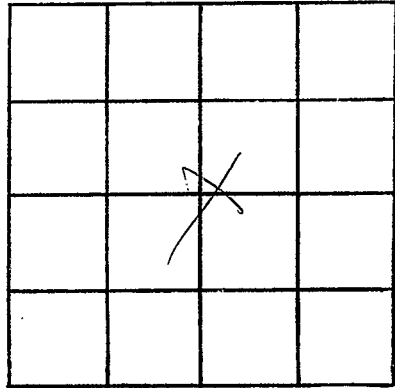

SECTION 23

Please indicate well location X.

ADDITIONAL INFORMATION

If more than one screen, show locations of each on sketch.