

Pike  
G 98  
8-11-72

MISSISSIPPI  
BOARD OF WATER COMMISSIONERS  
416 North State Street  
Jackson, Mississippi 39201

**CODED**

WATER WELL DRILLERS LOG

Aug 11 1972 *off well well* *Pelle*  
date well completed firm name county well located

LANDOWNER:	description of formations encountered	from	to
<i>George Slaughter</i>			
<i>R.R. Magnolia Mrs</i> (mailing address)	<i>Red clay</i>	<i>0</i>	<i>20</i>
	<i>Red gravel</i>	<i>20</i>	<i>105</i>
	<i>General sand</i>	<i>105</i>	<i>118</i>

WELL LOCATION:  
sec. 14 20 S R. 7 E W  
1 1/2 miles SW of Maguire  
(distance) (direction) (nearest town)

WELL PURPOSE: Home  
(home, irrigation, municipal, industrial)

- WELL COMPLETION DATA:
- (1) diameter (inches) 4
  - (2) total depth (feet) 118
  - (3) static water level (feet) 80 below top of ground.
  - (4) casing 4 110  
(material) (depth)  
4 if telescope see back.  
(size)
  - (5) screen 8 110  
(length) (depth to top)  
4 plastic  
(size) (material)
  - (6) pump 3/4 15  
(HP) (yield gpm)  
el  
(type power)
  - (7) electric log 2  
(yes or no)  
(organization running log)
  - (8) how well bottom plugged wood


**CODED**

DRILLERS REMARKS: SEP 7 1972

MISS. BD. OF  
WATER COMMISSIONERS

If well telescopes please sketch and show depths.

GROUND LEVEL

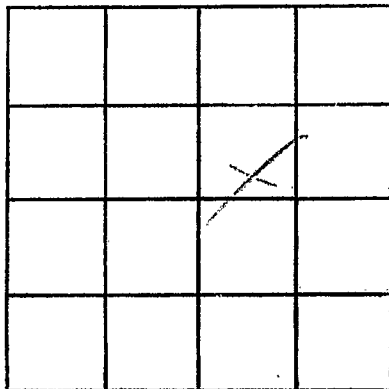

SECTION 17

Please indicate well location X.

ADDITIONAL INFORMATION

If more than one screen,  
show locations of each on sketch.