

Pike
G 99
8-17-72

MISSISSIPPI
BOARD OF WATER COMMISSIONERS
416 North State Street
Jackson, Mississippi 39201

WATER WELL DRILLERS LOG

CODED

Aug 17 19 72 Fitzgerald Pike
date well completed firm name county well located


LANDOWNER:	description of formations encountered	from	to
<u>J. M. Rimes</u>			
<u>R.R. Magnolia, Miss</u> (mailing address)	<u>Red clay</u> <u>Coarse sand & gravel</u> <u>Coarse sand & gravel</u>	<u>0</u> <u>20</u> <u>60</u>	<u>20</u> <u>60</u> <u>102</u>
WELL LOCATION:			
sec. <u>27</u> <u>2</u> ^N <u>5</u> R. <u>7</u> ^E			
<u>2</u> miles <u>SW</u> of <u>Magnolia</u> (distance) (direction) (nearest town)			
WELL PURPOSE: <u>Home</u> (home, irrigation, municipal, industrial)			
WELL COMPLETION DATA:			
(1) diameter (inches) <u>4</u>			
(2) total depth (feet) <u>102</u>			
(3) static water level (feet) <u>55</u> below above top of ground.			
(4) casing <u>Plastic</u> , <u>94</u> (material) (depth)			
<u>4</u> if telescope see back. (size)			
(5) screen <u>8</u> , <u>94</u> (length) (depth to top)			
<u>4</u> , <u>Plastic</u> (size) (material)			
(6) pump <u>1</u> , <u>20</u> (HP) (yield gpm)			
<u>Electric</u> (type power)			
(7) electric log <u>yes</u> (yes or no)			
(organization running log)			
(8) how well bottom plugged <u>absolutely</u>			
DRILLERS REMARKS:			

CODED

SEP 7 1972
MISSISSIPPI BOARD OF WATER COMMISSIONERS
WATER CONTROL

If well telescopes please sketch and show depths.

GROUND LEVEL

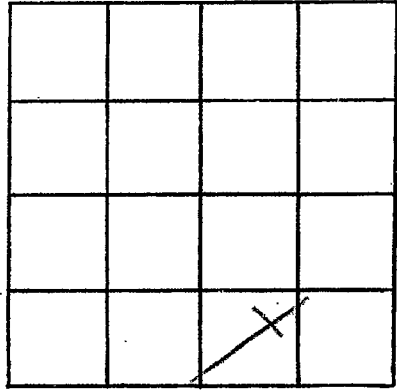

SECTION 27

Please indicate well location X.

ADDITIONAL INFORMATION

If more than one screen,
show locations of each on sketch.