

Pike  
G 100  
9-19-72

MISSISSIPPI  
BOARD OF WATER COMMISSIONERS  
416 North State Street  
Jackson, Mississippi 39201

**CODED**

WATER WELL DRILLERS LOG

9-19-72 date well completed      F. G. Galloway firm name      Pike county well located


LANDOWNER:	description of formations encountered	from	to
Curtis Leahy			
R.R. Maguire Min. (mailing address)	Red clay Red sand Coarse sand & gravel	0 20 80	20 80 128
WELL LOCATION:			
sec. 4 T. 20 S. R. 70 W.			
4 miles NW of Magnolia (distance) (direction) (nearest town)			
WELL PURPOSE: Home (home, irrigation, municipal, industrial)			
WELL COMPLETION DATA:			
(1) diameter (inches) 4	<b>CODED</b>		
(2) total depth (feet) 128			
(3) static water level (feet) 85 below top of ground.			
(4) casing Plastic, 120, (material) (depth)			
4 (size) if telescope see back.			
(5) screen 8, 120 (length) (depth to top)			
4 (size), Plastic (material)			
(6) pump 1/2 (HP) 10 (yield gpm)			
Glu (type power)			
(7) electric log no (yes or no)			
(organization running log)			
(8) how well bottom plugged wood plug			
DRILLERS REMARKS:			

OCT 17 1972

MISS. DIV. WATER CONTROL

If well telescopes please sketch and show depths.

GROUND LEVEL

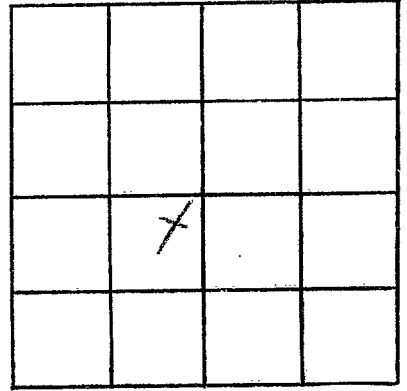

SECTION 4

Please indicate well location X.

ADDITIONAL INFORMATION

If more than one screen,  
show locations of each on sketch.