

**MISSISSIPPI
BOARD OF WATER COMMISSIONERS**
416 North State Street
Jackson, Mississippi 39201

WATER WELL DRILLERS LOG

Pike
G102
8-23-72

Aug 23 1972 Chester Reese Pike
date well completed firm name county well located

LANDOWNER: Faller
Uerner
Rt 2, Magnolia
(mailing address)

description of formations encountered	from	to
<u>clay</u>	<u>0</u>	<u>12</u>
<u>sand & gravel</u>	<u>12</u>	<u>38</u>

WELL LOCATION:
sec. 15 T. 2 N. R. 7 E
2 miles SW Magnolia
(distance) (direction) (nearest town)

WELL PURPOSE: Home
(home, irrigation, municipal, industrial)

WELL COMPLETION DATA:

- (1) diameter (inches) 4"
- (2) total depth (feet) 38
- (3) static water level (feet) 17 below top of ground.
- (4) casing Plast Ballon
(material) (depth)
- _____ if telescope see back.
(size)
- (5) screen 6' 32'
(length) (depth to top)
- 4" Plast
(size) (material)
- (6) pump Self pump
(HP) (yield gpm)
- elect
(type power)
- (7) electric log no
(yes or no)
- _____ (organization running log)


(8) how well bottom plugged wooden plug

DRILLERS REMARKS:
old 2" well
sanded

DEC 1 1972

If well telescopes please
sketch and show depths.

GROUND LEVEL

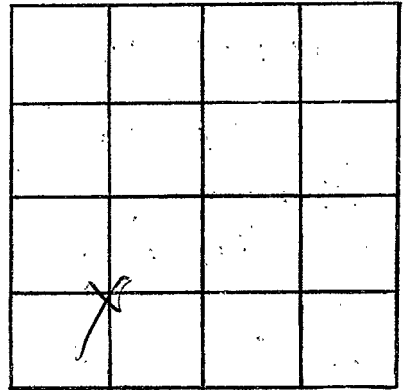

SECTION 15

Please indicate well location X.

ADDITIONAL INFORMATION

If more than one screen,
show locations of each on sketch.