

MISSISSIPPI
 BOARD OF WATER COMMISSIONERS
 416 North State Street
 Jackson, Mississippi 39201

CODED

WATER WELL DRILLERS LOG

Pike
 G103
 10-12-72

Oct 12 1972 Chester Keene Pike
 date well completed firm name county well located

LANDOWNER: George
McMurry
R. S. Magnolia
 (mailing address)

WELL LOCATION:
 sec. 28 T. 2 N. R. 7 E
3 1/2 miles SW of Magnolia
 (distance) (direction) (nearest town)

WELL PURPOSE: Home
 (home, irrigation, municipal, industrial)

WELL COMPLETION DATA:

(1) diameter (inches) 4"

(2) total depth (feet) 131

(3) static water level (feet) 96 below
 top of ground.

(4) casing Plast. Ballston
 (material) (depth)

 If telescope see back.
 (size)

(5) screen 12.5
 (length) (depth to top)

1/2" Plast
 (size) (material)

(6) pump 1/2 HP 12
 (HP) (yield gpm)

1/2 HP
 (type power)

(7) electric log NO
 (yes or no)

 (organization running log)

description of formations encountered	from	to
clay	0	12
Red Sandy Clay	12	82
Sand & gravel	82	114
Red chalk	114	119
Coarse Sand	119	131


CODED

DEC 4 1972

DRILLERS REMARKS:
well 2" well had

If well telescopes please sketch and show depths.

GROUND LEVEL

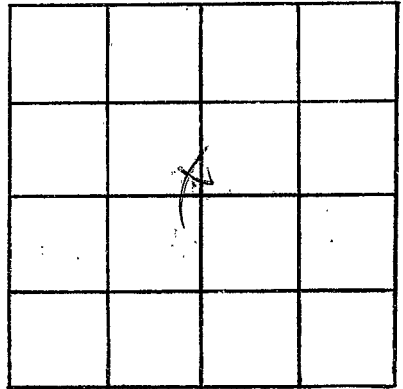

SECTION 28

Please indicate well location X.

ADDITIONAL INFORMATION

If more than one screen,
show locations of each on sketch.