

Pike
G106
5-23-73

MISSISSIPPI
BOARD OF WATER COMMISSIONERS
416 North State Street
Jackson, Mississippi 39201

CODED

WATER WELL DRILLERS LOG

5-23 19 73 Fitzgerald Well Serv Pike
date well completed firm name county well located

LANDOWNER:
Norman Bonder
R.R. Magnolia
(mailing address)

description of formations encountered	from	to
<u>Red Clay</u>	<u>0</u>	<u>20</u>
<u>Red gravel</u>	<u>20</u>	<u>80</u>
<u>Red Sand</u>	<u>80</u>	<u>105</u>
<u>Coarse Sand</u>	<u>105</u>	<u>118</u>

WELL LOCATION:
sec. 17 T. 20 S. R. 7 E.
3 miles W of Magnolia
(distance) (direction) (nearest town)

WELL PURPOSE: Home
(home, irrigation, municipal, industrial)

- WELL COMPLETION DATA:
- (1) diameter (inches) 4
 - (2) total depth (feet) 118
 - (3) static water level (feet) 20 below top of ground.
 - (4) casing plastic, 110,
(material) (depth)
4 if telescope see back.
(size)
 - (5) screen 8, 110
(length) (depth to top)
4, plastic
(size) (material)
 - (6) pump 1/2 10
(HP) (yield gpm)
Elm
(type power)
 - (7) electric log None
(yes or no)
(organization running log)
 - (8) how well bottom plugged retarded


CODED

DRILLERS REMARKS:

JUN 28 1973

If well telescopes please sketch and show depths.

GROUND LEVEL

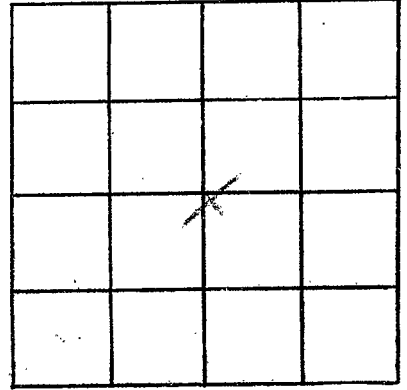

17

SECTION _____

Please indicate well location X.

ADDITIONAL INFORMATION

If more than one screen, show locations of each on sketch.