

PIKE

MISSISSIPPI
 BOARD OF WATER COMMISSIONERS
 416 North State Street
 Jackson, Mississippi 39201

CODED

WATER WELL DRILLERS LOG

PIKE

6-5
 date well completed

19 73 Fitzgerald Well Co
 firm name

PIKE
 county well located

LANDOWNER:

Unity Baptist Church

(Bell Park) R.R. Magnolia
 (mailing address)

description of formations encountered

from

to

Red clay020Red sand2080Red gravel8090Red silt90110Coarse sand & gravel110120**WELL LOCATION:**

sec. 17 T 2 N R 7 E
6 miles W of Magnolia
 (distance) (direction) (nearest town)

WELL PURPOSE: Home
 (home, irrigation, municipal, industrial)

WELL COMPLETION DATA:

- (1) diameter (inches) 4
- (2) total depth (feet) 120
- (3) static water level (feet) 80 below top of ground.
- (4) casing plastic, 112,
 (material) (depth)
4 if telescope see back.
 (size)
- (5) screen 8, 112
 (length) (depth to top)
4, plastic
 (size) (material)
- (6) pump 1/2 10
 (HP) (yield gpm)
elec
 (type power)
- (7) electric log no
 (yes or no)
 (organization running log)
- (8) how well bottom plugged wood peg


CODED

DRILLERS REMARKS:

JUN 28 1973

If well telescopes please sketch and show depths.

GROUND LEVEL

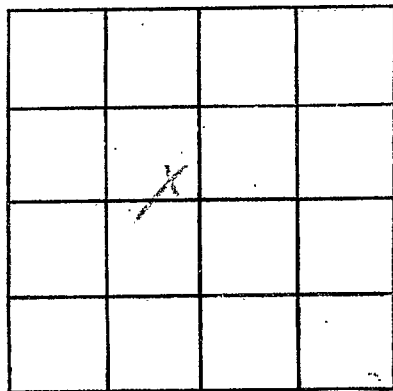

SECTION

Please indicate well location X.

79

ADDITIONAL INFORMATION

If more than one screen, show locations of each on sketch.