

Pike
G108
6-21-73

MISSISSIPPI
BOARD OF WATER COMMISSIONERS
416 North State Street
Jackson, Mississippi 39201

CODED

WATER WELL DRILLERS LOG

6-21 1973 Felgual Well of Pike
date well completed firm name county well located

LANDOWNER:
Cliff Lang
R.R. Maxolin
(drilling address)

description of formations encountered	from to	
<u>Red clay</u>	<u>0</u>	<u>20</u>
<u>Red sand</u>	<u>20</u>	<u>90</u>
<u>Coarse sand & gravel</u>	<u>90</u>	<u>104</u>

WELL LOCATION:
sec. 18 T. 2N S. R. 7E W.
5 miles W of Myrtle
(distance) (direction) (nearest town)

WELL PURPOSE:
Home
(home, irrigation, municipal, industrial)

- WELL COMPLETION DATA:
- (1) diameter (inches) 4
 - (2) total depth (feet) 104
 - (3) static water level (feet) 20 below above-top of ground.
 - (4) casing plastic 96 (material) (depth)
4 (size) if telescope see back.
 - (5) screen 8 (length) 96 (depth to top)
4 (size) plastic (material)
 - (6) pump 1/2 (HP) 10 (yield gpm)
Elec (type power)
 - (7) electric log No (yes or no)
(organization running log)
 - (8) how well bottom plugged closed by


CODED

JUN 28 1973

DRILLERS REMARKS:

If well telescopes please sketch and show depths.

GROUND LEVEL

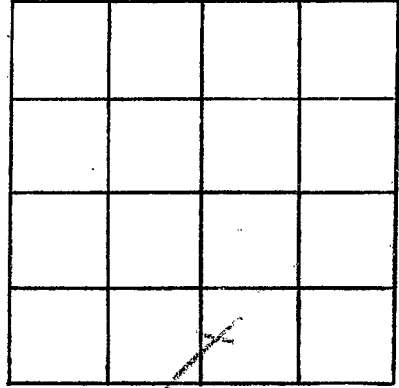

SECTION 18

Please indicate well location X.

ADDITIONAL INFORMATION

If more than one screen, show locations of each on sketch.