

G 110
 PIKE
 6-11-73

MISSISSIPPI
 BOARD OF WATER COMMISSIONERS
 416 North State Street
 Jackson, Mississippi 39201

CODED

WATER WELL DRILLERS LOG

June 11 1973 Cherokee Levees Pike
 date well completed firm name county well located

LANDOWNER Laurel Kennedy
Rt. 2, Magnolia
 (mailing address)

description of formations encountered	from	to
<u>Red clay</u>	<u>0</u>	<u>12</u>
<u>Red sand</u>	<u>12</u>	<u>70</u>
<u>Dequard sand</u>	<u>70</u>	<u>79</u>

WELL LOCATION:
 sec. 17 T 2 N R 7 E
3 1/2 miles W of Magnolia
 (distance) (direction) (nearest town)

WELL PURPOSE: Home Camp
 (home, irrigation, municipal, industrial)

- WELL COMPLETION DATA:
- (1) diameter (inches) 4"
 - (2) total depth (feet) 79
 - (3) static water level (feet) 17 below top of ground.
 - (4) casing Plast. Buttress
 (material) (depth)
 - _____ if telescope see back.
 (size)
 - (5) screen 6' 73'
 (length) (depth to top)
 - 4" Plast.
 (size) (material)
 - (6) pump 3/4 Sub 15
 (HP) (yield gpm)
 - Electric
 (type power)
 - (7) electric log no
 (yes or no)
 - _____ (organization running log)
 - (8) how well bottom plugged wooden plug


CODED

DRILLERS REMARKS:
New location

AUG 20 1973

If well telescopes please sketch and show depths.

GROUND LEVEL

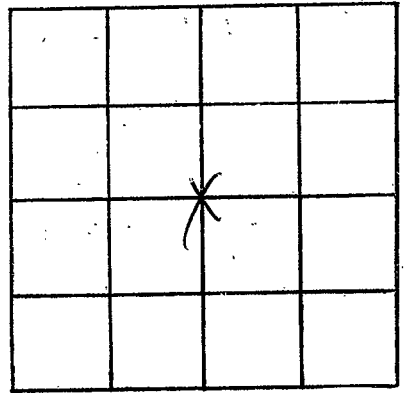

SECTION 17

Please indicate well location X.

ADDITIONAL INFORMATION

If more than one screen, show locations of each on sketch.