

G 111
 PIKE
 6-19-93

MISSISSIPPI
 BOARD OF WATER COMMISSIONERS
 416 North State Street
 Jackson, Mississippi 39201

CODED

WATER WELL DRILLERS LOG

June 19 1973 *Chester Reeves* *Pike*
 date well completed firm name county well located

LANDOWNER: *Frank Yuscovics*
H. Magnolia
 (mailing address)

description of formations encountered	from	to
<i>Red clay & gravel</i>	<i>0</i>	<i>16</i>
<i>Red sand</i>	<i>16</i>	<i>48</i>
<i>Small gravel sand</i>	<i>48</i>	<i>57</i>

WELL LOCATION:
 sec. *17* T. *2* N R. *7* E
3 1/2 miles *W* *Magnolia*
 (distance) (direction) (nearest town)

WELL PURPOSE: *farm*
 (home, irrigation, municipal, industrial)

- WELL COMPLETION DATA:
- (1) diameter (inches) *4"*
 - (2) total depth (feet) *57*
 - (3) static water level (feet) *34* below/above top of ground.
 - (4) casing *Plast*, *Butt*
 (material) (depth)
 _____ if telescope see back.
 (size)
 - (5) screen *4"*, *57'*
 (length) (depth to top)
4", *Plast*
 (size) (material)
 - (6) pump *1/2* *8*
 (HP) (yield gpm)
shot
 (type power)
 - (7) electric log *No*
 (yes or no)
 - _____ (organization running log)
 - (8) how well bottom plugged
wooden plug


CODED

DRILLERS REMARKS:
New location

AUG 20 1973

If well telescopes please sketch and show depths.

GROUND LEVEL

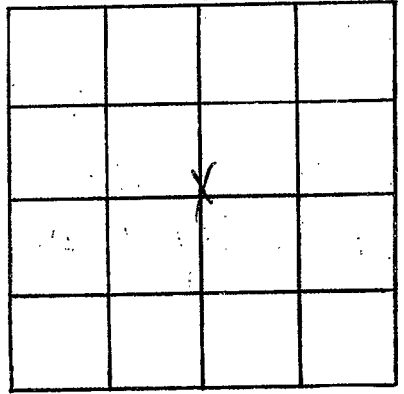

SECTION 17

Please indicate well location X.

ADDITIONAL INFORMATION

If more than one screen, show locations of each on sketch.