

PIKE
G112
8-28-73

MISSISSIPPI
BOARD OF WATER COMMISSIONERS
416 North State Street
Jackson, Mississippi 39201

CODED

WATER WELL DRILLERS LOG

28 Aug 1973 date well completed
 T. Cunningham firm name
 PIKE county well located

LANDOWNER:

R. T. Steptey
 Smithdale
 (mailing address)

description of formations encountered

from to

clay dirt	0	15
clay + sand	15	30
clay + chalk	30	48
sand & pea gravel	48	113

WELL LOCATION:

sec 4 T 2 N R 7 E
 S W
 3 miles west of Magnolia (distance) (direction) (nearest town)

WELL PURPOSE:

(home, irrigation, municipal, industrial)

WELL COMPLETION DATA:


- (1) diameter (inches) 4 1/4
- (2) total depth (feet) 113
- (3) static water level (feet) 30 below top of ground
- (4) casing (material) PL (depth) 107
- (size) If telescope see back.
- (5) screen (length) 6 (depth to top) 107
- (size) 4 (material) PL
- (6) pump (HP) 1/2 (yield gpm) 5
- (type power) elect
- (7) electric log (yes or no)
- (organization running log)
- (8) how well bottom plugged wood

CODED

DRILLERS REMARKS:

If well telescopes please sketch and show depths.

GROUND LEVEL

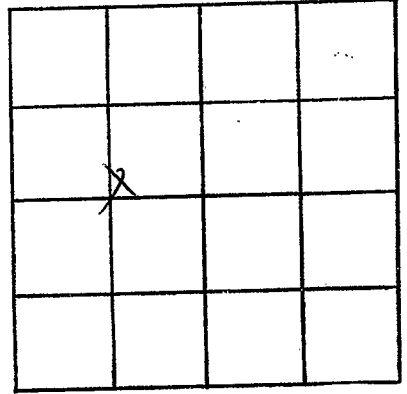

SECTION 4

Please indicate well location X.

ADDITIONAL INFORMATION

If more than one screen, show locations of each on sketch.