

PIKE  
 G 113  
 10-18-73

MISSISSIPPI  
 BOARD OF WATER COMMISSIONERS  
 416 North State Street  
 Jackson, Mississippi 39201

**CODED**

WATER WELL DRILLERS LOG

Oct 18 1973 date well completed  
 Chester Keener firm name  
 Pike county well located

LANDOWNER: W. J. Summers  
 Magnolia

| description of formations encountered | from | to |
|---------------------------------------|------|----|
| white clay                            | 0    | 12 |
| white sand                            | 12   | 26 |
| chalk & sand                          | 26   | 48 |
| coarse sand                           | 48   | 57 |

(mailing address)  
 WELL LOCATION:  
 sec. 26 T. 2 N. R. 7 E.  
 2 miles S. SE of Magnolia

WELL PURPOSE: Camp house  
 (home, irrigation, municipal, industrial)

- WELL COMPLETION DATA:
- (1) diameter (inches) 4 1/2
  - (2) total depth (feet) 57
  - (3) static water level (feet) 3 below top of ground
  - (4) casing Plast Bottom (material) (depth)
  - (5) screen 6' (length), 57 (depth to top), 4 1/2" (size), Plast (material)
  - (6) pump old Humphreys (HP) (yield gpm)
  - (7) electric log NO (yes or no)
  - (8) how well bottom plugged wooden plug


**CODED**

DRILLERS REMARKS:  
 New location - Camp house.

NOV 7 1973  
 MISS. STATE UNIV.  
 WATER RESOURCES

If well telescopes please  
sketch and show depths.

GROUND LEVEL

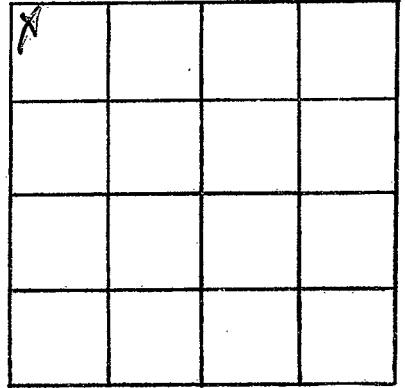

SECTION 26

Please indicate well location X.

ADDITIONAL INFORMATION

If more than one screen,  
show locations of each on sketch.