

PIKE  
G 14  
7-18-73

MISSISSIPPI  
BOARD OF WATER COMMISSIONERS  
416 North State Street  
Jackson, Mississippi 39201

**CODED**

WATER WELL DRILLERS LOG

July 15 1973 Chester Keener Pike  
date well completed firm name county well located

LANDOWNER: Charlie Williams

description of formations encountered

from

to

Rt 3, McComb (mailing address)

Red clay	0	16
Red sand	16	72
Chalk gravel	72	94
Sand & gravel	94	100

WELL LOCATION:

sec. 10 T. 2 N R. 7 E  
1/2 miles W Magnolia (distance) (direction) (nearest town)

WELL PURPOSE: Spine (home, irrigation, municipal, industrial)

WELL COMPLETION DATA:

- (1) diameter (inches) 4"  
(2) total depth (feet) 100  
(3) static water level (feet) 68 below top of ground.  
(4) casing Plast Ballam (material) (depth)  
if telescope see back. (size)  
(5) screen 0' 94' (length) (depth to top)  
4" Plast (size) (material)  
(6) pump 1/2 Sub-15 (HP) (yield gpm)  
Electric (type power)  
(7) electric log No (yes or no)

**CODED**

(organization running log)


(8) how well bottom plugged wooden plug

DRILLERS REMARKS: well had old 2"

NOV 7 1973

If well telescopes please sketch and show depths.

GROUND LEVEL

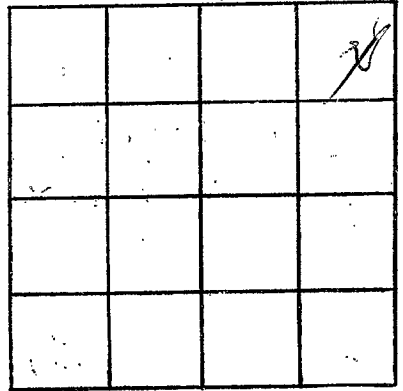

SECTION 10

Please indicate well location X.

ADDITIONAL INFORMATION

If more than one screen,  
show locations of each on sketch.