

PIKE
G 116
12-7-73

MISSISSIPPI
BOARD OF WATER COMMISSIONERS
416 North State Street
Jackson, Mississippi 39201

CODED

WATER WELL DRILLERS LOG

7 Dec 1973 *Ames Park Well Dr* *Pike*
date well completed firm name county well located

LANDOWNER:
Bornie Coleman
Magr
(mailing address)

WELL LOCATION:
sec. *10* T. *2* N. R. *7* E
3 miles *W* of *Magr*
(distance) (direction) (nearest town)

WELL PURPOSE:
(home, irrigation, municipal, industrial)

- WELL COMPLETION DATA:
- (1) diameter (inches) *4*
 - (2) total depth (feet) *107*
 - (3) static water level (feet) *70* below above top of ground.
 - (4) casing *pl*, *101*,
(material) (depth)
 If telescope see back.
(size)
 - (5) screen *6*, *101*
(length) (depth to top)
4, *pl*
(size) (material)
 - (6) pump *1/2*, *8*
(HP) (yield gpm)
short
(type power)
 - (7) electric log
(yes or no)

(organization running log)
 - (8) how well bottom plugged *wood*

description of formations encountered	from	to
<i>clay</i>	<i>0</i>	<i>25</i>
<i>chert</i>	<i>25</i>	<i>55</i>
<i>sand chert</i>	<i>55</i>	<i>75</i>
<i>red chert</i>	<i>75</i>	<i>107</i>


CODED

DRILLERS REMARKS:

INDEXED
FEB 12 1974
MISS. BU. OF WATER COMMISSIONERS

If well telescopes please sketch and show depths.

GROUND LEVEL

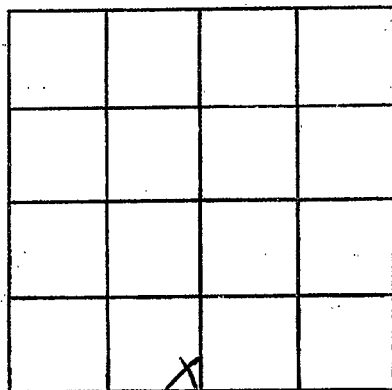

SECTION 10

Please indicate well location X.

ADDITIONAL INFORMATION

If more than one screen,
show locations of each on sketch.