

PIKE  
G 117  
3-25-74

MISSISSIPPI  
BOARD OF WATER COMMISSIONERS  
416 North State Street  
Jackson, Mississippi 39201

CODED

WATER WELL DRILLERS LOG

3-25

1974

*Lyons Well Service*

*Pike*

date well completed

firm name

county well located

LANDOWNER:

*Deiana Powell*

description of formations encountered

from

to

*R.R. Magnolia*  
(mailing address)

*Red clay*  
*Red sand*  
*Red gravel*

*0 20*  
*20 80*  
*80 110*

WELL LOCATION:

sec. *29* T. *2* (N) R. *7* (E)  
*4* miles *SW* of *Magnolia*  
(distance) (direction) (nearest town)

*Coarse sand & gravel*

*110 120*

WELL PURPOSE:

(home, irrigation, municipal, industrial)

*Home*

WELL COMPLETION DATA:

- (1) diameter (inches) *4*
- (2) total depth (feet) *120*
- (3) static water level (feet) *90* below above top of ground.
- (4) casing *Plastic 112*,  
(material) (depth)  
*4* if telescope see back.  
(size)
- (5) screen: *8 112*  
(length) (depth to top)  
*4 Plastic*  
(size) (material)
- (6) pump: *1/2 10*  
(HP) (yield gpm)  
*elec*  
(type power)
- (7) electric log: *no*  
(yes or no)
- (organization running log)
- (8) how well bottom plugged: *Seal shot*


CODED

DRILLERS REMARKS:

APR 1 1974  
MISS. Bd. of Water Com.

If well telescopes please sketch and show depths.

GROUND LEVEL

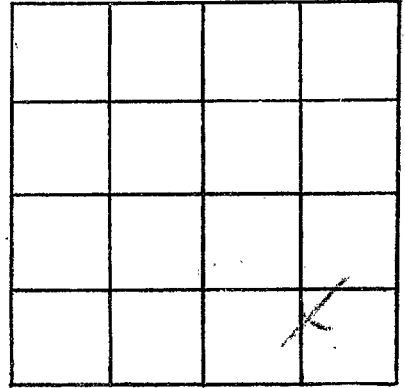

SECTION 29

Please indicate well location X.

ADDITIONAL INFORMATION

If more than one screen,  
show locations of each on sketch.