

PIKE
G 118
4-6-74

MISSISSIPPI
BOARD OF WATER COMMISSIONERS
416 North State Street
Jackson, Mississippi 39201

CODED

WATER WELL DRILLERS LOG

6 April 1974 J.T. Conington Pike
date well completed firm name county well located

LANDOWNER:	description of formations encountered	from	to
Ben Weatherly Mag. (mailing address)	Clay Sand Clay Sand	0 10 25 30	00 25 30 48
<p>WELL LOCATION:</p> <p>sec. 9 T 2 N R 7 E 4 miles W of Mag. (distance) (direction) (nearest town)</p>			
<p>WELL PURPOSE: (home, irrigation, municipal, industrial)</p>			
<p>WELL COMPLETION DATA:</p>			
<p>(1) diameter (inches) 4</p>			
<p>(2) total depth (feet) 48</p>			
<p>(3) static water level (feet) 15 below top of ground.</p>			
<p>(4) casing 41 (material), 42 (depth)</p>			
<p>(size) If telescope see back.</p>			
<p>(5) screen 6 (length), 42 (depth to top)</p>			
<p>4 (size), 41 (material)</p>			
<p>(6) pump 1/2 (HP), 8 (yield gpm)</p>			
<p>chart (type power)</p>			
<p>(7) electric log (yes or no)</p>			
<p>(organization running log)</p>			
<p>(8) how well bottom plugged wood</p>			
<p>DRILLERS REMARKS:</p>			

CODED


RECORDED

MAY 10 1974

MISS. Bd. OF WATER COMMISSIONERS

If well telescopes please sketch and show depths.

GROUND LEVEL

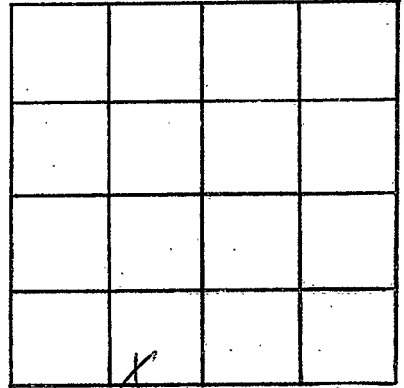

SECTION 9

Please indicate well location X.

ADDITIONAL INFORMATION

If more than one screen, show locations of each on sketch.