

PIKE
G/119
5-1-74

MISSISSIPPI
BOARD OF WATER COMMISSIONERS
416 North State Street
Jackson, Mississippi 39201

CODED

WATER WELL DRILLERS LOG

5/16/74 19
date well completed

J.T. Cunningham Son
firm name

Pike
county well located

LANDOWNER: Henry Dykes

description of formations encountered

from to

Rt. 2

Red Sand + clay

0 20

Magnolia, Ms.

Gravel + Sand

20 40

(mailing address)

Clay

40 60

Sand

60 82

WELL LOCATION:

sec. 9 T 2 N R 7 E
3 miles W of Map.
(distance) (direction) (nearest town)

WELL PURPOSE:
(home, irrigation, municipal, industrial)

CODED

WELL COMPLETION DATA:


- (1) diameter (inches) 4"
- (2) total depth (feet) 82
- (3) static water level (feet) _____ below
top of ground. above
- (4) casing PVC, 68'
(material) (depth)
4"
(size) if telescope see back.
- (5) screen 14', _____
(length) (depth to top)
4", PVC
(size) (material)
- (6) pump _____ (HP) _____ (yield gpm)
(type power)
- (7) electric log No
(yes or no)
(organization running log)
- (8) how well bottom plugged wood

DRILLERS REMARKS:

RECEIVED
JUL 11 1974

If well telescopes please sketch and show depths.

GROUND LEVEL

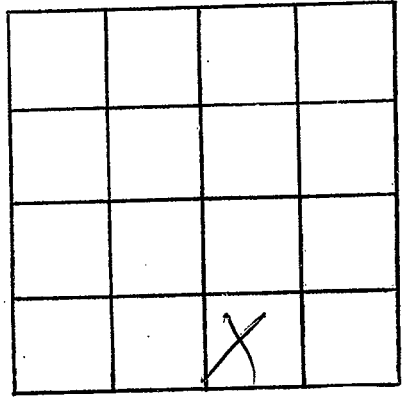

SECTION 9

Please indicate well location X.

ADDITIONAL INFORMATION

If more than one screen, show locations of each on sketch.