

MISSISSIPPI
BOARD OF WATER COMMISSIONERS
416 North State Street
Jackson, Mississippi 39201

CODED

WATER WELL DRILLERS LOG

PIKE
G 121
7-27-74

7/27/74 date well completed J.T. Conroy & Co. firm name Pike county well located

LANDOWNER: Du Beaudin
Mag. (mailing address)

WELL LOCATION:
sec. 23 T. 2 N R. 7 E
2 miles (distance) N (direction) of Mag. (nearest town)


WELL PURPOSE:
(home, irrigation, municipal, industrial)

WELL COMPLETION DATA:

(1) diameter (inches) 4
(2) total depth (feet) 220
(3) static water level (feet) 1 above top of ground.
(4) casing PL 129 (material) (depth)
if telescope see back.
(5) screen 199 (length) (depth to top)
4 (size) (material)
(6) pump (HP) (yield gpm)
(type power)
(7) electric log (yes or no)
(organization running log)
(8) how well bottom plugged

description of formations encountered	from	to
clay	0	15
Sand	15	45
Sand	45	70
Clay	70	95
Sand	95	220


DRILLERS REMARKS:
Flow well

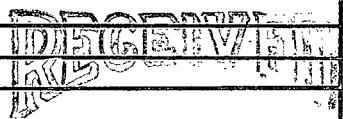

AUG 21 1974

If well telescopes please sketch and show depths.

GROUND LEVEL

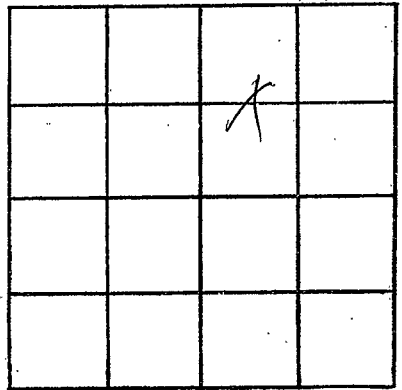

SECTION 23

Please indicate well location X.

ADDITIONAL INFORMATION

If more than one screen, show locations of each on sketch.