

PIKE
 G 124
 9/12/74

MISSISSIPPI
 BOARD OF WATER COMMISSIONERS
 416 North State Street
 Jackson, Mississippi 39201
 WATER WELL DRILLERS LOG

CODED.

9-12 1974 F. L. Gumbel Well Service Boke
 date well completed firm name county well located

LANDOWNER:
Bill Ferguson
R.R. Macrotin Miss.
 (mailing address)


description of formations encountered	from	to
<u>Red clay</u>	<u>0</u>	<u>20</u>
<u>Red sand</u>	<u>20</u>	<u>80</u>
<u>Coarse sand & gravel</u>	<u>80</u>	<u>88</u>

WELL LOCATION:
 sec. 15 T 2 (N) R 7 (E)
2 miles W of Magnolia
 (distance) (direction) (nearest town)

WELL PURPOSE:
Home
 (home, irrigation, municipal, industrial)

CODED

- WELL COMPLETION DATA:
- (1) diameter (inches) 4
 - (2) total depth (feet) 88
 - (3) static water level (feet) 73 below above top of ground.
 - (4) casing plaster (material), 80 (depth),
4 (size) if telescope see back.
 - (5) screen 8 (length), 80 (depth to top),
4 (size), plaster (material)
 - (6) pump 1/2 (HP), 10 (yield gpm),
elec (type power)
 - (7) electric log ny (yes or no)
(organization running log)
 - (8) how well bottom plugged Sand block

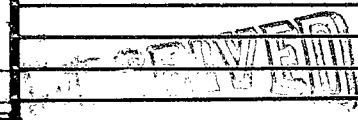


1167 20 1974

DRILLERS REMARKS:

MISC.

If well telescopes please sketch and show depths.

GROUND LEVEL

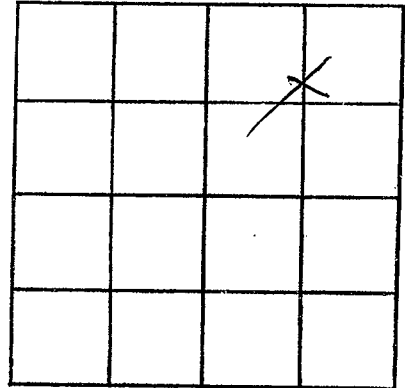

SECTION 15

Please indicate well location X.

ADDITIONAL INFORMATION

If more than one screen, show locations of each on sketch.