

PIKE
 67125
 9-9-74

MISSISSIPPI
 BOARD OF WATER COMMISSIONERS
 416 North State Street
 Jackson, Mississippi 39201

EDICODED

WATER WELL DRILLERS LOG


April 9 1974 *Chester Keener* *Pike*
 date well completed firm name county well located

LANDOWNER: <i>Carl Felder</i> <i>Rt 3, McCamb</i>	description of formations encountered	from	to
(mailing address)	<i>Red clay</i>	0	19
WELL LOCATION:	<i>Red sand</i>	19	62
sec. <i>10</i> T. <i>2</i> N. R. <i>7</i> E.	<i>Sand & gravel</i>	62	76
<i>2</i> miles <i>NW</i> of <i>Wagnolia</i>	<i>Red chack</i>	76	81
(distance) (direction) (nearest town)	<i>gravel sand</i>	91	100
WELL PURPOSE: <i>same</i>			
(home, irrigation, municipal, industrial)			
WELL COMPLETION DATA:			
(1) diameter (inches) <i>4</i>			
(2) total depth (feet) <i>100</i>			
(3) static water level (feet) <i>62</i> below top of ground <i>above</i>			
(4) casing <i>Plast. bottom</i>			
(material) (depth)			
(size) if telescope see back.			
(5) screen <i>6'</i> <i>96'</i>			
(length) (depth to top)			
<i>1 1/2"</i> <i>Plast</i>			
(size) (material)			
(6) pump <i>1/2</i> <i>1 1/2</i>			
(HP) (yield gpm)			
<i>Electric</i>			
(type power)			
(7) electric log <i>NO</i>			
(yes or no)			
(organization running log)			
(8) how well bottom plugged			
<i>Wooden plug</i>			
DRILLERS REMARKS: <i>old pump</i>			
<i>Cashed well bond.</i>			

RECEIVED
 OCT 20 1974
 WATER COMMISSION

If well telescopes please sketch and show depths.

GROUND LEVEL

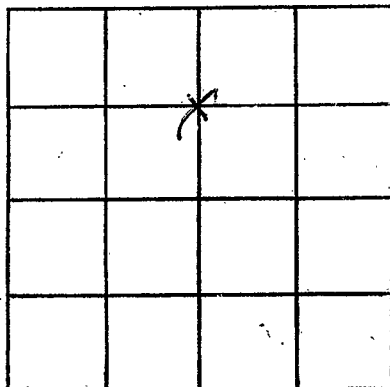

SECTION 10

Please indicate well location X.

ADDITIONAL INFORMATION

If more than one screen, show locations of each on sketch.