

PIKE
G 126
423-79

MISSISSIPPI
BOARD OF WATER COMMISSIONERS
416 North State Street
Jackson, Mississippi 39201

CODED

WATER WELL DRILLERS LOG


April 23 1974 Pheasant Run Rebo
date well completed firm name county well located

LANDOWNER: <u>Edward Lamb</u>	description of formations encountered	from	to
<u>H. S. McCamb</u> (mailing address)			
WELL LOCATION: sec. <u>4</u> T. <u>2</u> N. R. <u>1</u> E <u>5</u> miles <u>SW</u> of <u>McCamb</u> (distance) (direction) (nearest town)	<u>Red sand</u>	<u>20</u>	<u>38</u>
WELL PURPOSE: <u>House</u> (home, irrigation, municipal, industrial)	<u>Sand & gravel</u>	<u>38</u>	<u>44</u>
WELL COMPLETION DATA: (1) diameter (inches) <u>4"</u>	<u>Red sand</u>	<u>44</u>	<u>81</u>
(2) total depth (feet) <u>110</u>	<u>Sand pack</u>	<u>81</u>	<u>-</u>
(3) static water level (feet) <u>60</u> below top of ground.	<u>lobbally</u>	<u>81</u>	<u>100</u>
(4) casing <u>Plast. bottom</u> (material) (depth)	<u>Red gravel & sand</u>	<u>100</u>	<u>110</u>
(5) screen <u>6"</u> <u>100'</u> (length) (depth to top)			
(6) pump <u>1/2 sub</u> <u>12</u> (HP) (yield gpm)			
(7) electric log <u>NO</u> (yes or no)			
(8) how well bottom plugged <u>wooden plug</u>			
DRILLERS REMARKS: <u>no previous well</u>			

REGISTERED
MAY 8 1974

If well telescopes please sketch and show depths.

GROUND LEVEL

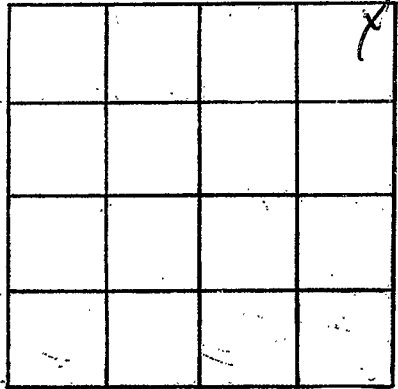

SECTION 4

Please indicate well location X.

ADDITIONAL INFORMATION

If more than one screen,
show locations of each on sketch.