

PIKE
G 128
7-18-74

MISSISSIPPI
BOARD OF WATER COMMISSIONERS
416 North State Street
Jackson, Mississippi 39201

CODED

WATER WELL DRILLERS LOG

July 18 1974 Chester Keener Pike
 date well completed firm name county well located

LANDOWNER: Charles Coak
RT 4
Magnolia
 (mailing address)

WELL LOCATION:
 sec 36 T 2 N R 7 E
3 1/2 miles S Magnolia
 (distance) (direction) (nearest town)

WELL PURPOSE: Home
 (home, irrigation, municipal, industrial)

- WELL COMPLETION DATA:
- (1) diameter (inches) 1 1/2"
 - (2) total depth (feet) 94
 - (3) static water level (feet) 61 below above
 top of ground.
 - (4) casing Plast Ballast
 (material) (depth)
 - (size) 6" If telescope see back.
 - (5) screen 6' 78'
 (length) (depth to top)
 - 4" Plast
 (size) (material)
 - (6) pump 1/2 Sub 12
 (HP) (yield gpm)
 - 3 lead
 (type power)
 - (7) electric log No
 (yes or no)
 - (organization running log)

description of formations encountered	from	to
<u>clay & gravel</u>	<u>0</u>	<u>20</u>
<u>Red gravel & sand</u>	<u>20</u>	<u>48</u>
<u>blue gravel & sand</u>	<u>48</u>	<u>60</u>
<u>pink chalk</u>	<u>60</u>	<u>76</u>
<u>Red gravel & sand</u>	<u>76</u>	<u>94</u>

(8) how well bottom plugged wooden plug


DRILLERS REMARKS: no.
Homeowner well.

RECEIVED

OCT 27 1974

If well telescopes please sketch and show depths.

GROUND LEVEL

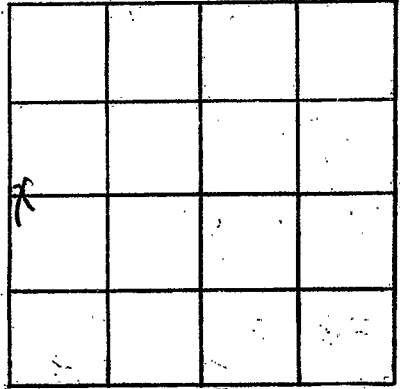

SECTION 36

Please indicate well location X.

ADDITIONAL INFORMATION

If more than one screen, show locations of each on sketch.