

PIKE
G 129
10/2/74

MISSISSIPPI
BOARD OF WATER COMMISSIONERS
416 North State Street
Jackson, Mississippi 39201 CODED
WATER WELL DRILLERS LOG

2 Oct 1974 Amor Pakwell Sec Pike
date well completed firm name county well located

LANDOWNER: Claudia Howard
Mag.
(mailing address)

description of formations encountered	from	to
<u>clay</u>	<u>0</u>	<u>25</u>
<u>cherty sand</u>	<u>25</u>	<u>45</u>
<u>sand</u>	<u>45</u>	<u>87</u>

WELL LOCATION:
sec. 3 T. 2 N. R. 7 E
3 miles NW of Mag.
(distance) (direction) (nearest town)

WELL PURPOSE:
(home, irrigation, municipal, industrial)

WELL COMPLETION DATA:

(1) diameter (inches) 4

(2) total depth (feet) 97

(3) static water level (feet) 70 below above top of ground.

(4) casing pl, 81
(material) (depth)

 If telescope see back.
(size)

(5) screen 6, 81
(length) (depth to top)

4, pl
(size) (material)

(6) pump elit, 8
(HP) (yield gpm)

shot
(type power)

(7) electric log
(yes or no)

(organization running log)

(8) how well bottom plugged wood

CODED


RECEIVED

DEC 3 1974

DRILLERS REMARKS:

If well telescopes please sketch and show depths.

GROUND LEVEL

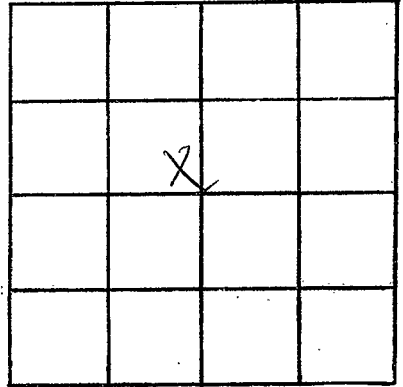

SECTION 3

Please indicate well location X.

ADDITIONAL INFORMATION

If more than one screen,
show locations of each on sketch.