

PIKE  
G 132  
2-25-74

MISSISSIPPI  
BOARD OF WATER COMMISSIONERS  
416 North State Street  
Jackson, Mississippi 39201

CODED

WATER WELL DRILLERS LOG

Feb 25 1974 date well completed  
Chester Reeves firm name  
Pebco county well located

LANDOWNER: James Rhodes  
Rt 4, Magnolia  
(mailing address)

WELL LOCATION:  
sec. 36 T 2 N R 7 E 14H  
3 1/2 miles South of May.  
(distance) (direction) (nearest town)

WELL PURPOSE: Farm  
(home, irrigation, municipal, industrial)


- WELL COMPLETION DATA:
- (1) diameter (inches) 10'
  - (2) total depth (feet) 102'
  - (3) static water level (feet) 61' below top of ground.
  - (4) casing: Plast Buttern (material) (depth)
  - (size) if telescope see back.
  - (5) screen: 6' (length), 96' (depth to top)  
4" Plast (size) (material)
  - (6) pump: owners old pump (HP) (yield/gpm)  
Elect. (type power)
  - (7) electric log NO (yes or no)
  - (organization running log)

(8) how well bottom plugged  
woodruff plug

DRILLERS REMARKS:  
old well had

description of formations encountered	from	to
Red clay	0	24
Red sand	24	62
Sand & gravel	62	76
Red chalk	76	79
Sand & gravel	79	102

CODED

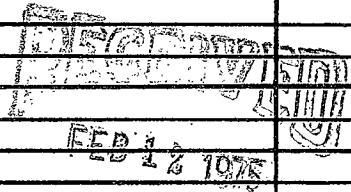

MISS. BD. OF WATER COMMISSIONERS

If well telescopes please sketch and show depths.

GROUND LEVEL

			X

SECTION 36

Please indicate well location X.

ADDITIONAL INFORMATION

If more than one screen, show locations of each on sketch.