

Pike
G 136
4-28-75

MISSISSIPPI
BOARD OF WATER COMMISSIONERS
416 North State Street
Jackson, Mississippi 39201

CODED

WATER WELL DRILLERS LOG

April 28 1975 Chester Reeves
date well completed firm name

Pike
county well located

LANDOWNER:

Mr. Bill Richardson
Rt. Magnolia miss
(mailing address)

description of formations encountered

from to

WELL LOCATION:

sec. 19 T 2 N R. 7 E 14th
_{S #}

5 miles S-SW of Magnolia
(distance) (direction) (nearest town)

WELL PURPOSE: Home
(home, irrigation, municipal, industrial)

WELL COMPLETION DATA:

- (1) diameter (inches) 4"
- (2) total depth (feet) 103
- (3) static water level (feet) 55 below top of ground.
- (4) casing plastic bottom
(material) (depth)
- If telescope see back.
(size)
- (5) screen 6' 97
(length) (depth to top)
- 4" plastic
(size) (material)
- (6) pump 1/2" Sub 10
(HP) (yield gpm)
- elect
(type power)
- (7) electric log NO
(yes or no)

(organization running log)

(8) how well bottom plugged
Wooden plug

DRILLERS REMARKS:


rod pump worn
out

description of formations encountered	from	to
<u>Red clay</u>	<u>0</u>	<u>19</u>
<u>Red sand</u>	<u>19</u>	<u>46</u>
<u>sand & gravel</u>	<u>46</u>	<u>65</u>
<u>Cherty sand & gravel</u>	<u>65</u>	<u>94</u>
<u>broken gravel & sand</u>	<u>94</u>	<u>103</u>

REGISTERED
JUN 20 1975

If well telescopes please sketch and show depths.

GROUND LEVEL

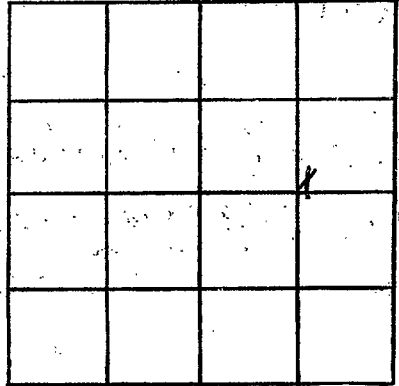

SECTION 19

Please indicate well location X.

ADDITIONAL INFORMATION

Lined area for additional information.

If more than one screen, show locations of each on sketch.