

Pike
 G 140
 8-18-75

MISSISSIPPI
 BOARD OF WATER COMMISSIONERS
 416 North State Street
 Jackson, Mississippi 39201

WATER WELL DRILLERS LOG

Aug 18 1975 ^{14th} Reems Well Drilling Pike
 date well completed firm name county well located


LANDOWNER:	description of formations encountered	from	to
(mailing address)			
Eugene Hall	Red clay	0	21
Rt. Magnolia	loam	21	40
	sand & gravel	40	65
	pink chert	65	102
	pebbles	102	117
WELL LOCATION:			
sec. 36 T. 2 N. R. 7 E			
3 1/2 miles South of Magnolia (distance) (direction) (nearest town)			
WELL PURPOSE: Home (home, irrigation, municipal, industrial)			
WELL COMPLETION DATA:			
(1) diameter (inches) 4"			
(2) total depth (feet) 117			
(3) static water level (feet) 65 below top of ground.			
(4) casing Plastic bottom (material) (depth)			
(5) screen 6" (length) 111 (depth to top)			
1 1/2" plastic (size) (material)			
(6) pump 3/4 HP (HP) 8 (yield gpm)			
Electric (type power)			
(7) electric log No (yes or no)			
(organization running log)			
(8) how well bottom plugged			
Wooden plug			
DRILLERS REMARKS:			
new house site			

RECEIVED
 OCT 20 1975

MISS. Bd. OF WATER QUALITY

If well telescopes please sketch and show depths.

GROUND LEVEL

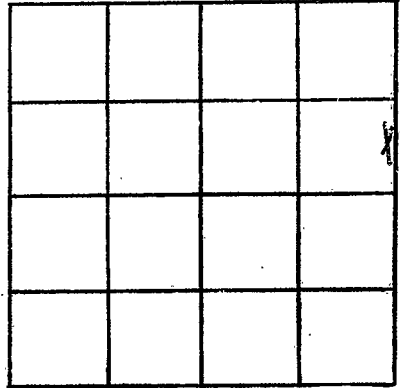

SECTION 36

Please indicate well location X.

ADDITIONAL INFORMATION

If more than one screen,
show locations of each on sketch.