

PIKE  
 5142  
 9/20/78

MISSISSIPPI  
 BOARD OF WATER COMMISSIONERS  
 416 North State Street  
 Jackson, Mississippi 39201

CODED

WATER WELL DRILLERS LOG

70 Sept 1978 *Prosser Waterworks* *Pike*  
 date well completed firm name county well located

LANDOWNER:  
*R. A. Vi Bedham*  
*Magnolia*  
 (mailing address)

description of formations encountered	from	to
<i>Clay</i>	<i>0</i>	<i>15</i>
<i>Clay &amp; Sand</i>	<i>15</i>	<i>65</i>
<i>Chalk</i>	<i>65</i>	<i>135</i>
<i>Sand</i>	<i>135</i>	<i>170</i>
	<b>CODED</b>	

WELL LOCATION:  
 sec. 23 T 2 N R. 7 E  
 S W  
2 miles S of Magnolia  
 (distance) (direction) (nearest town)

WELL PURPOSE:  
 (home, irrigation, municipal, industrial)

WELL COMPLETION DATA:

(1) diameter (inches) 4

(2) total depth (feet) 170

(3) static water level (feet) 70 above top of ground.

(4) casing PI 140  
 (material) (depth)  
 (size) if telescope see back.

(5) screen 30 140  
 (length) (depth to top)  
4 PI  
 (size) (material)

(6) pump - 40  
 (HP) (yield gpm)  
Flow  
 (type power)

(7) electric log (yes or no)  
(organization running log)


(8) how well bottom plugged Not

DRILLERS REMARKS:  
*Good Flow well*

**REGISTERED**  
 OCT 10 1978  
 MISS. BD. OF WATER COMMISSIONERS

If well telescopes please sketch and show depths.

GROUND LEVEL

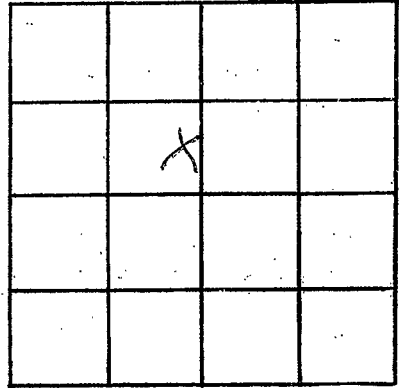

SECTION 73

Please indicate well location X.

ADDITIONAL INFORMATION

If more than one screen, show locations of each on sketch.