

County: Pike
 Permit #: _____
 Driller: Fitzgerald Well Service
 Date drilling completed: 8-2-05

State Well Report
Part 1 - Driller's Log

Mississippi Department of Environmental Quality
 Office of Land and Water Resources
 P.O. Box 10631
 Jackson, MS 39289-0631
 (601)961-5210
 (601)354-6938 (fax)

For Office Use Only:
 Aquifer: _____
 Well #: G-156
 L. S. Elevation: _____
 E-log #: _____

State Law requires that this report be prepared by the license holder responsible for the work and filed with the Department at the above address within 30 days of completion of drilling of the well or borehole.

| Information on Well Owner <i>(Landowner if borehole is not for a water well)</i> | Well or Borehole Location |
|---|---|
| Owner Name: <u>Ramon Prescott</u> | Latitude: _____ Longitude: _____ |
| Mailing Address: <u>Muddy Springs Rd</u> | Method of Lat Long (circle one): Conventional Survey |
| <u>Magnolia, MS</u> | USGS quad, Hand-held GPS, Survey-grade GPS |
| City State Zip Code | <u>1/4 Sec 17 Twn 2N Rng 7E</u> |
| Telephone No. () _____ | Distance <u>4</u> Miles <u>West</u> Direction of <u>Magnolia</u> Nearest Town |

Well / Borehole Data

Date drilling started: 8-2-05 Date drilling completed: 8-2-05 Hole depth: 100' Hole diameter: 8"

Location of the source of any surface water used for drilling: _____
 Method of dosing and volume of Chlorine used in drilling and development: _____

Logs run (circle all applicable): No log run Electric Gamma Ray Density Sonic Neutron Other: _____
 Name of organization running log(s): _____

Purpose of borehole (check one): Water Well Geotechnical Geological Investigation _____ Ground Source Heat Pump _____
 Seismic Survey _____ Other (describe) _____

If drilling is not related to water well construction, skip the remainder of this block

Purpose of Well (check one): Home Industrial _____ Public Supply _____ Irrigation _____ Fish Culture _____ Other: _____

If a flowing well, method of flow regulation: Valve _____ Other (describe) _____

Static Water Level: 70' feet above or below (circle one) land surface Date measured: 8-2-05

Method of Measurement (circle one) steel tape electric tape air line other: _____

Well depth: 100' Well grouted to a depth of 10 feet Type of grout (circle one): Neat Cement Bentonite Mix

Casing length: 90' feet Casing diameter: 4" inches Type of casing: PVC

Screen length: 10' feet Screen diameter: 4" inches Type of screen: PVC

Screen slot size: .012 inches Setting depth: From 90' feet to 100' feet

Type of completion (circle all applicable): Gravel packed Underreamed Telescoped Open hole Natural Development
 Other (describe): _____


Top of lap pipe or reduction in casing: _____ feet. *If telescoped or more than one screen, describe on next page*

Form: OLWR-SWR-1A

RECEIVED
AUG 18 2005
BY: OLWR

The sketch below only required for water wells

if well telescopes, show depths on sketch.

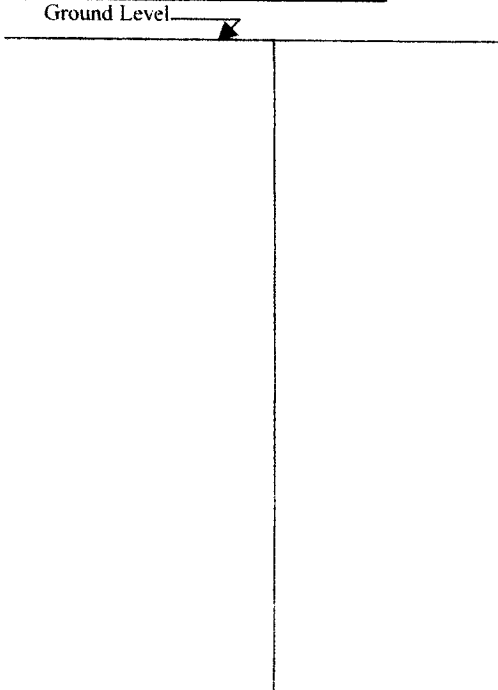


Description of formations encountered must be provided for all wells and boreholes, unless specifically exempted by regulations

| Description of Formations Encountered | From (depth) Ground Level | To (depth) |
|---------------------------------------|------------------------------|------------|
| clay | 0 | 20 |
| sand + gravel | 20 | 60 |
| gravel | 60 | 80 |
| sand | 80 | 90 |
| course sand + gravel | 90 | 100 |
| | | |
| | | |
If more than one screen, show location of each on sketch

Sketch the property layout and include the following: 1) the well location; 2) any permanent structures on the property that may aid in locating the well; 3) any roads, power lines, or other items that may aid in locating the property and the well; 4) a north arrow.

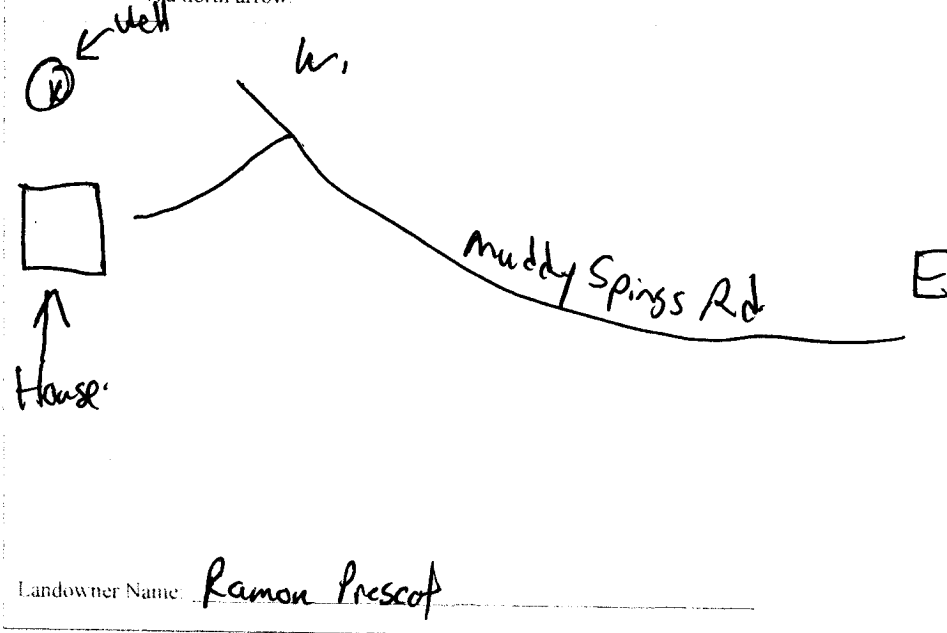

Landowner Name: Ramon Prescott

Form: OLWR-SWR-1A

I certify that the well/borehole was drilled, constructed, and completed in accordance with all applicable requirements of the Mississippi Department of Environmental Quality and the Mississippi Department of Health regulations, if applicable, and state laws.

BRAD Fitzgerald 029- 8-2-05 *Beal Fitzgerald*
 Print Name of Responsible Licensee and License No. Date Signature of Licensee

RECEIVED
 AUG 18 2005
 BY: OLWR

STATE WELL REPORT

Part 2

Pump Installer's Completion Report
 Mississippi Department of Environmental Quality
 Office of Land and Water Resources
 P.O. Box 10631
 Jackson, MS 39289-0631
 (601)961-5210
 (601)354-6938 (fax)

County LiKe
 Permit # _____
 Driller Fitzgerald Well Services
 Date completed 8-2-05
Copy information from block on Part 1

For Office Use Only:

Aquifer: _____
 Well #: G-156
 Elevation: _____

This part of the report must be completed by a licensed water well contractor or a licensed pump installer. A copy of Part 1 of the report must be attached and both parts filed with the Department at the above address within 30 days of well completion.

| Well Owner Information | Well Location |
|--|--|
| Owner Name: <u>Ramon Prescott</u> | Latitude: _____ Longitude: _____ |
| Mailing Address: <u>Muddy Springs Rd</u> | Method of Lat Long (check one): Conventional Survey _____ |
| <u>Magnolia MS</u> | USGS quad _____ Hand-held GPS _____ Survey-grade GPS _____ |
| City _____ State _____ Zip Code _____ | _____ 1/4 _____ 1/4 Sec <u>17</u> T <u>2N</u> R <u>7E</u> |
| Telephone No. (_____) _____ | Distance _____ Direction _____ Nearest Town _____ |
| | <u>4</u> Miles <u>West</u> of <u>Magnolia</u> |

| Pump Type Circle one | Power Type Circle one |
|---|---|
| Air Lift _____ Jet _____ <u>Submersible</u> | Diesel Engine _____ Gasoline Engine _____ Natural Gas _____ |
| Bucket _____ Piston _____ Turbine _____ | <u>Electric Motor</u> _____ Hand _____ Tractor PTO _____ |
| Centrifugal _____ Rotary _____ Flowing Well _____ | Windmill _____ Other (specify): _____ |
| Other (specify): _____ | Horse Power Rating of Motor: <u>3/4</u> |
| Date Pump Installed: <u>8-2-05</u> | Setting Depth: <u>95'</u> feet |
| Rated Pump Capacity: <u>12</u> Gallons Per Minute | Number of Stages: <u>12</u> |

| Pump Test Data | Method of Measuring Water Level Circle one |
|--|--|
| Date Well Tested: _____ | Air Line _____ Electric Measuring Line _____ <u>Steel Tape</u> |
| Static Water Level (A): _____ Feet Below Land Surface | Other (specify): _____ |
| Pumping Water Level (B): _____ Feet Below Land Surface | For flowing well, measured shut in head: _____ feet |
| Drawdown [(B) - (A)]: _____ Feet Below Land Surface | Well yielded _____ GPM with a drawdown of _____ |
| Test Pumping Rate: _____ Gallons Per Minute | _____ feet after _____ hours of pumping |
| Duration of Pump Test (minimum 4 hours): _____ hours | |

I HEREBY CERTIFY that the above statements are true to the best of my knowledge.

Brad Fitzgerald Brad Fitzgerald
 Print Name of Pump Installer and License No. (if applicable) Signature of Pump Installer

Form: OLWR-SWR-1B

RECEIVED

AUG 18 2005

BY: OLWR