

Pike
 G 2000
 10-8-75

MISSISSIPPI
 BOARD OF WATER COMMISSIONERS
 416 North State Street
 Jackson, Mississippi 39201

WATER WELL DRILLERS LOG

Oct 8 1975 *Anna Well Serv* *Pike*
 date well completed firm name county well located

LANDOWNER:
Attie Bond
Rt. Macedonia
 (mailing address)

description of formations encountered	from	to
<i>Red clay</i>	<i>0</i>	<i>18</i>
<i>Chalk & sand</i>	<i>18</i>	<i>50</i>
<i>fine gravel & sand</i>	<i>50</i>	<i>73</i>


WELL LOCATION:
 sec. *20* T. *2* N R. *7* E
1 1/2 miles *West* of *Magnolia*
 (distance) (direction) (nearest town)

WELL PURPOSE: *Home*
 (home, irrigation, municipal, industrial)

- WELL COMPLETION DATA:
- (1) diameter (inches) *4"*
 - (2) total depth (feet) *73*
 - (3) static water level (feet) *40* below top of ground.
 - (4) casing *plastic bottom*
 (material) (depth)
 - If telescope see back.
 (size)
 - (5) screen *6"* *67*
 (length) (depth to top)
 - 4"* *plastic*
 (size) (material)
 - (6) pump *1/2* *10*
 (HP) (yield gpm)
 - split*
 (type power)
 - (7) electric log *no*
 (yes or no)
 - (organization running log)

(8) how well bottom plugged
wooden plug


DRILLERS REMARKS:
well house

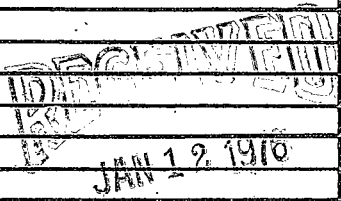

MISS. Bd. OF WATER COMMISSIONERS

If well telescopes please sketch and show depths.

GROUND LEVEL

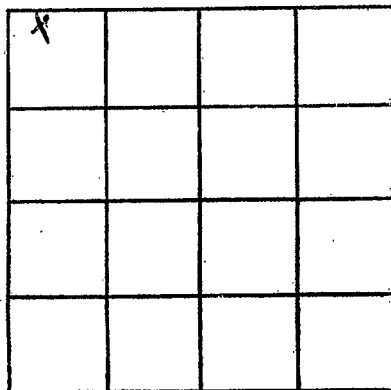

SECTION 20

Please indicate well location X.

ADDITIONAL INFORMATION

If more than one screen,
show locations of each on sketch.