

Pike
 G 2001
 11-14-75

MISSISSIPPI
 BOARD OF WATER COMMISSIONERS
 416 North State Street
 Jackson, Mississippi 39201

WATER WELL DRILLERS LOG

11-14
 date well completed

14H 75 Fitzgerald Well Ser
 firm name

Pike
 county well located

LANDOWNER:
 Betty Sue Harris
 R.R. Magnolia
 (mailing address)


description of formations encountered	from	to
Red clay	0	20
Red sand	20	52
White + blue clay	52	104
Coarse sand	104	115

WELL LOCATION:
 sec. 15 T 20 N R 9 E
 S
 1 miles W of Magnolia
 (distance) (direction) (nearest town)

WELL PURPOSE: Home
 (home, irrigation, municipal, industrial)

- WELL COMPLETION DATA:
- (1) diameter (inches) 4
 - (2) total depth (feet) 115
 - (3) static water level (feet) 70 above top of ground.
 - (4) casing plastic, 107 (material) (depth)
 4 (size) if telescope see back.
 - (5) screen 8, 107 (length) (depth to top)
 4 (size) plastic (material)
 - (6) pump 1/2 (HP) 10 (yield gpm)
 electric (type power)
 - (7) electric log no (yes or no)
 (organization running log)
 - (8) how well bottom plugged sand block


DRILLERS REMARKS:

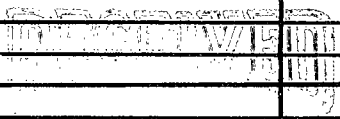

DEC 17 1975

If well telescopes please sketch and show depths.

GROUND LEVEL

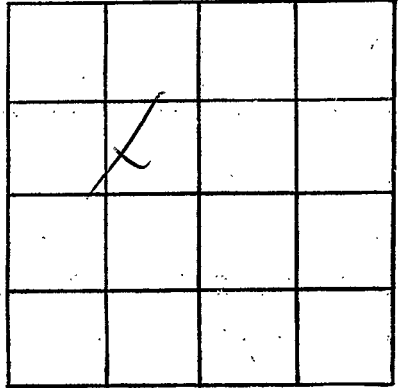

SECTION 15

Please indicate well location X.

ADDITIONAL INFORMATION

If more than one screen, show locations of each on sketch.