

PIKE  
 G 2003  
 3-2-76

MISSISSIPPI  
 BOARD OF WATER COMMISSIONERS  
 416 North State Street  
 Jackson, Mississippi 39201

WATER WELL DRILLERS LOG

Pike  
~~Amos Parke Well Service~~

7 March 19 <sup>14th</sup> Amos Parke Well Service firm name  
 county well located

LANDOWNER:  
 Dr. A. V. Beacham  
 Mags Miss  
 (mailing address)


description of formations encountered	from	to
clay	0	25
sand	25	60
cherty	60	75
sand	75	198

WELL LOCATION:  
 sec 20 T 20 N R 70 E  
 2 miles S of Mags  
 (distance) (direction) (nearest town)

WELL PURPOSE:  
 (home, irrigation, municipal, industrial)

- WELL COMPLETION DATA:
- (1) diameter (inches) 4
  - (2) total depth (feet) 198
  - (3) static water level (feet) 72 below top of ground
  - (4) casing (material) pl (depth) 177  
 (size) If telescope see back.
  - (5) screen 21 (length) 177 (depth to top)  
 4 (size) pl (material)
  - (6) pump (HP) (yield gpm) None  
 (type power)
  - (7) electric log (yes or no)
  - (organization running log)
  - (8) how well bottom plugged None


DRILLERS REMARKS:

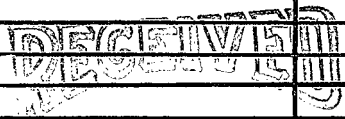

APR 20 1976

If well telescopes, please sketch and show depths.

GROUND LEVEL

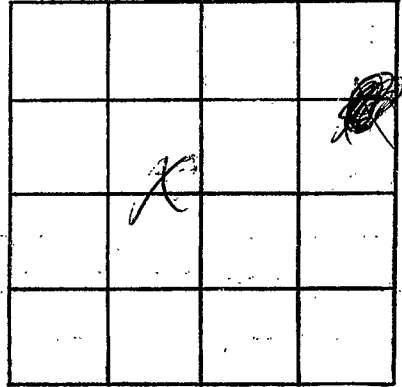

SECTION 730

Please indicate well location X.

ADDITIONAL INFORMATION

If more than one screen, show locations of each on sketch.