

Pike
 G 2005
 5-5-76

MISSISSIPPI
 BOARD OF WATER COMMISSIONERS
 416 North State Street
 Jackson, Mississippi 39201

WATER WELL DRILLERS LOG

5 May 1976 date well completed
 14th J.C. Constantine firm name
 Pike county well located


LANDOWNER:	description of formations encountered	from	to
D. Buchanan			
Magnolia (mailing address)	Clay	0	15
WELL LOCATION: sec. 23 T 24N R 7E 2 miles S of Magee	Sandstone	15	20
(distance) (direction) (nearest town)	Sandstone	30	70
WELL PURPOSE: Home Irrigation, municipal, industrial	Cherty	20	40
WELL COMPLETION DATA:	Sand	80	198
(1) diameter (inches) 4			
(2) total depth (feet) 198			
(3) static water level (feet) 110 below top of ground.			
(4) casing (material) PI (depth) 177			
(size) If telescope see back.			
(5) screen (length) 21 (depth to top) 197			
(size) 4 (material) PI			
(6) pump (HP) 10-15 (yield gpm)			
(type power)			
(7) electric log (yes or no)			
(organization running log)			
(8) how well bottom plugged			
DRILLERS REMARKS:			
Doesn't flow as well as other wells nearby			

RECEIVED

JUL 29 1976

If well telescopes please sketch and show depths.

GROUND LEVEL

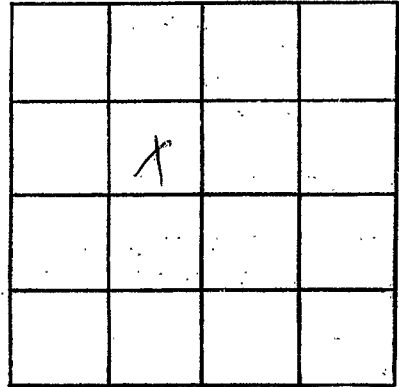

SECTION 2

Please indicate well location X.

ADDITIONAL INFORMATION

If more than one screen, show locations of each on sketch.