

Pipe
 G 2000
 5-7-76

MISSISSIPPI
 BOARD OF WATER COMMISSIONERS
 416 North State Street
 Jackson, Mississippi 39201

WATER WELL DRILLERS LOG


5-7 1976 *Flycatcher* *Pike*
 date well completed firm name county well located

LANDOWNER:	description of formations encountered	from	to
<i>Rally Deer</i>			
<i>RR Magnolia Miss.</i> (mailing address)	<i>Red Clay</i> <i>Subs.</i> <i>Coarse Sand & gravel</i>	<i>0</i> <i>20</i> <i>80</i>	<i>20</i> <i>80</i> <i>90</i>
WELL LOCATION:			
sec. <i>13</i> T. <i>2</i> (N) S. R. <i>7</i> (E) W.			
<i>1/2</i> miles <i>E</i> of <i>Magnolia</i> (distance) (direction) (nearest town)			
WELL PURPOSE: <i>Home</i> (home, irrigation, municipal, industrial)			
WELL COMPLETION DATA:			
(1) diameter (inches) <i>4</i>			
(2) total depth (feet) <i>90</i>			
(3) static water level (feet) <i>45</i> below top of ground.			
(4) casing <i>PVC</i> , <i>82</i> (material) (depth)			
<i>4</i> if telescope see back. (size)			
(5) screen <i>8</i> , <i>82</i> (length) (depth to top)			
<i>4</i> , <i>PVC</i> (size) (material)			
(6) pump <i>1/2</i> , <i>60</i> (HP) (yield gpm)			
<i>60</i> (type power)			
(7) electric log <i>no</i> (yes or no)			
(organization running log)			
(8) how well bottom plugged <i>Seal shell</i>			
DRILLERS REMARKS:			

1976
 MISSISSIPPI BOARD OF WATER COMMISSIONERS
 OFFICE OF WATER CONTROL

If well telescopes please sketch and show depths.

GROUND LEVEL

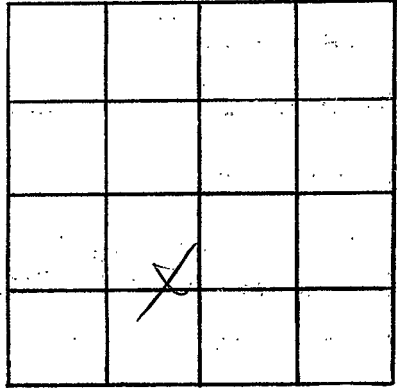

SECTION 13

Please indicate well location X.

ADDITIONAL INFORMATION

If more than one screen,
show locations of each on sketch.